


1 LOCATION OF WATER WELL: Fraction NE 1/4 NE 1/4 NE 1/4 Section Number 22 Township Number T 25 S Range Number R 21 EW  
 County: Ford

Distance and direction from nearest town or city street address of well if located within city?  
2 1/2 east, 3/4 south of Bellefont, Ks.

2 WATER WELL OWNER: Reynold & Rexwinkle  
 RR#, St. Address, Box #: 212 North Market Board of Agriculture, Division of Water Resources  
 City, State, ZIP Code: Wichita, Ks. 67202 Application Number: 920365

3 LOCATE WELL'S LOCATION WITH AN "X" IN SECTION BOX:

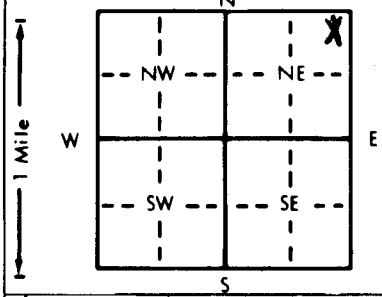

4 DEPTH OF COMPLETED WELL: 100 ft. ELEVATION: .....  
 Depth(s) Groundwater Encountered 1. .... ft. 2. .... ft. 3. .... ft.  
 WELL'S STATIC WATER LEVEL: 5.0 ft. below land surface measured on mo/day/yr 10-24-92  
 Pump test data: Well water was ..... ft. after ..... hours pumping ..... gpm  
 Est. Yield: na gpm: Well water was ..... ft. after ..... hours pumping ..... gpm  
 Bore Hole Diameter: 1.0 in. to 1.00 ft., and ..... in. to ..... ft.  
 WELL WATER TO BE USED AS:  
 5 Public water supply 8 Air conditioning 11 Injection well  
 1 Domestic 3 Feedlot 6 Oil field water supply 9 Dewatering 12 Other (Specify below)  
 2 Irrigation 4 Industrial 7 Lawn and garden only 10 Monitoring well .....  
 Was a chemical/bacteriological sample submitted to Department? Yes.....No...x.....; If yes, mo/day/yr sample was submitted  
 Water Well Disinfected? Yes hth No

5 TYPE OF BLANK CASING USED:  
 1 Steel 3 RMP (SR) 5 Wrought iron 8 Concrete tile CASING JOINTS: Glued x Clamped .....  
2 PVC 4 ABS 6 Asbestos-Cement 9 Other (specify below) Welded .....  
 7 Fiberglass ..... Threaded .....

Blank casing diameter: 5 in. to 6.0 ft., Dia ..... in. to ..... ft., Dia ..... in. to ..... ft.  
 Casing height above land surface: 2 in., weight 25.8 lbs./ft. Wall thickness or gauge No. ....

TYPE OF SCREEN OR PERFORATION MATERIAL:  
 1 Steel 3 Stainless steel 5 Fiberglass 7 PVC 10 Asbestos-cement  
 2 Brass 4 Galvanized steel 6 Concrete tile 8 RMP (SR) 11 Other (specify) .....  
 12 None used (open hole)

SCREEN OR PERFORATION OPENINGS ARE:  
 1 Continuous slot 3 Mill slot 5 Gauzed wrapped 8 Saw cut 11 None (open hole)  
 2 Louvered shutter 4 Key punched 6 Wire wrapped 9 Drilled holes  
 7 Torch cut 10 Other (specify) .....

SCREEN-PERFORATED INTERVALS: From 6.0 ft. to 10.0 ft., From ..... ft. to ..... ft.  
 From ..... ft. to ..... ft., From ..... ft. to ..... ft.  
 GRAVEL PACK INTERVALS: From 2.0 ft. to 1.00 ft., From ..... ft. to ..... ft.  
 From ..... ft. to ..... ft., From ..... ft. to ..... ft.

6 GROUT MATERIAL: 1 Neat cement 2 Cement grout 3 Bentonite 4 Other hole plug  
 Grout Intervals: From 0 ft. to 2.0 ft., From ..... ft. to ..... ft., From ..... ft. to ..... ft.

What is the nearest source of possible contamination:  
 1 Septic tank 4 Lateral lines 7 Pit privy 10 Livestock pens 14 Abandoned water well  
 2 Sewer lines 5 Cess pool 8 Sewage lagoon 11 Fuel storage 15 Oil well/Gas well  
 3 Watertight sewer lines 6 Seepage pit 9 Feedyard 12 Fertilizer storage 16 Other (specify below)  
 13 Insecticide storage .....

Direction from well? north How many feet? 100'

FROM	TO	LITHOLOGIC LOG	FROM	TO	PLUGGING INTERVALS
0	2	Top soil			
2	5	Brown & gray clay			
5	38	Brown & white rock			
38	41	Brown rock, clay & sand mixed			
41	44	Sand rock			
44	47	Light gray clay, yellow brown rock & clay			
47	50	Sand rock Hard Dark brown cland black			
50	54	Blue gray clay & shale			
54	75	Sand rock			
75	80	Red sand rock & red clayand black sand rock			
80	100	Sand rock			

7 CONTRACTOR'S OR LANDOWNER'S CERTIFICATION: This water well was (1) constructed, (2) reconstructed, or (3) plugged under my jurisdiction and was completed on (mo/day/year) 10-24-92 and this record is true to the best of my knowledge and belief. Kansas Water Well Contractor's License No. 134 This Water Well Record was completed on (mo/day/yr) 11-2-92 under the business name of Rosencrantz-Bemis by (signature) Freddie Dodson