


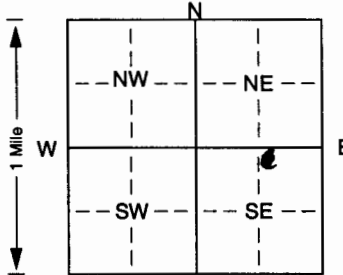

1 LOCATION OF WATER WELL: **NW NE SE** Section Number **36** Township Number **T 25 S** Range Number **R 21 E**

County: **Ford** Distance and direction from nearest town or city street address of well if located within city? **1W + 3 1/2 S from Offerle**

2 WATER WELL OWNER: **William Herrmann** RR#, St. Address, Box #: **Offerle, KS 67563** Board of Agriculture, Division of Water Resources Application Number:


 WELL WATER TO BE USED AS:  Domestic  3 Feedlot  6 Oil field water supply  9 Dewatering  12 Other (Specify below)  
 2 Irrigation  4 Industrial  7 Domestic (lawn & garden)  10 Monitoring well

Was a chemical/bacteriological sample submitted to Department? Yes. . . . . No. ; If yes, mo/day/yr sample was submitted  
 Water Well Disinfected? Yes  No

5 TYPE OF BLANK CASING USED:  1 Steel  3 RMP (SR)  6 Asbestos-Cement  9 Other (specify below) CASING JOINTS:  Glued  Clamped  Welded  Threaded

2 PVC  4 ABS  7 Fiberglass


TYPE OF SCREEN OR PERFORATION MATERIAL:  PVC  10 Asbestos-cement  
 1 Steel  3 Stainless steel  5 Fiberglass  8 RMP (SR)  11 Other (specify)  12 None used (open hole)  
 2 Brass  4 Galvanized steel  6 Concrete tile  9 ABS

SCREEN OR PERFORATION OPENINGS ARE:  1 Continuous slot  3 Mill slot  5 Gauzed wrapped  8 Saw cut  11 None (open hole)  
 2 Louvered shutter  4 Key punched  6 Wire wrapped  9 Drilled holes  
 7 Torch cut  10 Other (specify)  12 None used (open hole)




What is the nearest source of possible contamination:  1 Septic tank  4 Lateral lines  7 Pit privy  10 Livestock pens  14 Abandoned water well  
 2 Sewer lines  5 Cess pool  8 Sewage lagoon  11 Fuel storage  15 Oil well/Gas well  
 3 Watertight sewer lines  6 Seepage pit  9 Feedyard  12 Fertilizer storage  16 Other (specify below)  
 13 Insecticide storage

Direction from well? **E** How many feet? **500**

FROM	TO	LITHOLOGIC LOG	FROM	TO	PLUGGING INTERVALS
0	7	top soil			
7	55	brown, red, blue, yellow clay			
55	70	soft sandstone			
70	110	brown clay			
110	120	sand			

7 CONTRACTOR'S OR LANDOWNER'S CERTIFICATION: This water well was  constructed, (2) reconstructed, or (3) plugged under my jurisdiction and was completed on (mo/day/year) **4-22-02** and this record is true to the best of my knowledge and belief. Kansas Water Well Contractor's Licence No. **101** This Water Well Record was completed on (mo/day/yr) **4-23-02** under the business name of **Bardel Well Drilling, Inc.** by (signature) **Kenney J. Bantel**