WATER WELL RECORD Form WWC-5 KSA 82a-1212

1 LOCATION OF WATER WELL:	Fraction	Section Number	Township Number	Range Number
COUNTY: 029 FORD	NE 1/4 NE 1/4 NE 1/4	29	T 25 S	R 21 W

Distance and direction from nearest town or city street address of well if located within city?
1 E. 1 S. OF BELLEFONT,KS

2 WATER WELL OWNER: CARL HUBBELL 403
RR#, St. Address, Box # : 10405 132 ROAD
Board of Agriculture, Division of Water Resources

City, State, ZIP code : SPEARVILLE, KS 67876-
Application Number:

3 LOCATE WELL'S LOCATION WITH AN "X" IN SECTION BOX:

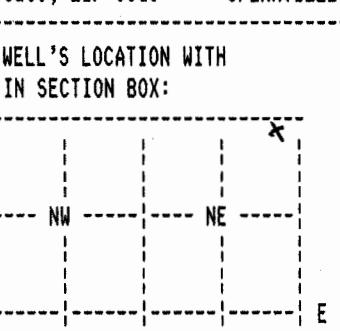

4 DEPTH OF COMPLETED WELL 215 ELEVATION: 0
Depth(s) Groundwater Encountered 1. 0 ft. 2. 0 ft. 3. 0 ft.

WELL'S STATIC WATER LEVEL 0 ft. below land surface measured on mo/day/yr
Pump testdata: Well water was 0 ft. after 0 hours pumping 0 gpm

Estimated Yield 0 gpm: Well water was 0 ft. after 0 hours pumping 0 gpm

Bore Hole Diameter 8.75 in. to 215 ft., and in. to 0 ft.

WELL WATER TO BE USED AS: 01 DOMESTIC

Was a chemical/bacteriological sample submitted to department? No ;
If yes, mo/day/yr sample was submitted
Water well disinfected? Yes

5 TYPE OF BLANK CASING USED: 02 PVC CASING JOINTS: GLUED
Blank casing diameter 5 in. to 195 ft., Dia in. to 0 ft., Dia in. to 0 ft.
Casing height above land surface 12 in., weight 0 lbs/ft. Wall thickness or gauge No. 21-26
TYPE OF SCREEN OR PERFORATION MATERIAL: 07 PVC
SCREEN OR PERFORATION OPENINGS ARE: 08 SAW CUT

SCREEN PERFORATED INTERVALS:	From 195 ft. to	215 ft., From	0 ft. to	0 ft.
	From 0 ft. to	0 ft., From	0 ft. to	0 ft.
GRAVEL PACK INTERVALS:	From 25 ft. to	215 ft., From	0 ft. to	0 ft.
	From 0 ft. to	0 ft., From	0 ft. to	0 ft.

6 GROUT MATERIAL 03 BENTONITE
Grout Intervals: From 3 ft. to 25 ft., From 0 ft. to 0 ft., From 0 ft. to 0 ft.
What is the nearest source of possible contamination: 01 SEPTIC TANK
Direction from well? E
How many feet? 55

FROM	TO	LITHOLOGIC LOG	FROM	TO	PLUGGING INTERVALS
0	30	TAN CLAY			
30	41	05 SAND AND GYPSUM			
41	49	GREY CLAY			
49	50	BROWN 21 LIMESTONE			
50	195	19 SHALE			
195	215	SANDSTONE			

7 CONTRACTOR'S OR LANDOWNER'S CERTIFICATION: This water well was Constructed under my jurisdiction and was completed on (mo/day/year) 12/11/97 and this record is true to the best of my knowledge and belief. Kansas Water Well Contractor's License No. 224 This Water Well Record was completed on (mo/day/yr) 12/31/97 under the business name of CARL HAYSE WATER WELL SVC by (signature) Carl Hayse