


1 LOCATION OF WATER WELL:	Fraction	Section Number	Township Number	Range Number
County: Ford	NE ¼ SW ¼ SW ¼	17	T 25 S	R 21

EW

Distance and direction from nearest town or city street address of well if located within city?
10275 Commercial, Spearville

2 WATER WELL OWNER: Offerle Co-op
 RR#, St. Address, Box # : **P.O. Box 90**
 City, State, ZIP Code : **Offerle, Kansas 67563**

Board of Agriculture, Division of Water Resources
 Application Number:

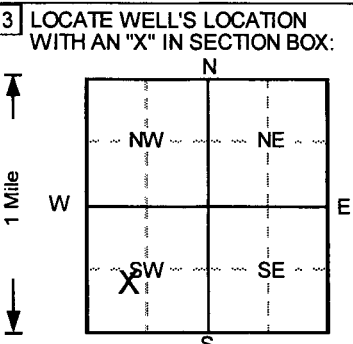

4 DEPTH OF COMPLETED WELL **35** ft. **ELEVATION:**

Depth(s) Groundwater Encountered 1. ft. 2. ft. 3. ft.

WELL'S STATIC WATER LEVEL **23** ft. below land surface measured on mo/day/yr **4/16/2007**

Pump test data: Well water was **NA** ft. after hours pumping gpm

Est. Yield . . **NA** gpm: Well water was ft. after hours pumping gpm

Bore Hole Diameter **8** in. to **35** ft., and in. to ft.

WELL WATER TO BE USED AS: 5 Public water supply 8 Air conditioning 11 Injection well
 1 Domestic 3 Feedlot 6 Oil field water supply 9 Dewatering 12 Other (Specify below)
 2 Irrigation 4 Industrial 7 Lawn and garden only **10 Monitoring well**

Was a chemical/bacteriological sample submitted to Department? Yes.....No ; If yes, mo/day/yr sample was submitted

Water Well Disinfected? Yes No

5 TYPE OF BLANK CASING USED:

1 Steel	3 RMP (SR)	6 Asbestos-Cement	9 Other (specify below)	CASING JOINTS: Glued	Clamped
2 PVC	4 ABS	7 Fiberglass		Welded	

Blank casing diameter **2** in. to **20** ft, Dia in. to ft, Dia in. to ft.

Casing height above land surface **0** in., weight lbs./ft. Wall thickness or gauge No. **Sch. 40**

TYPE OF SCREEN OR PERFORATION MATERIAL

1 Steel	3 Stainless steel	5 Fiberglass	7 PVC	10 Asbestos-cement
2 Brass	4 Galvanized steel	6 Concrete tile	8 RMP (SR)	11 Other (specify)
			9 ABS	12 None used (open hole)

SCREEN OR PERFORATION OPENINGS ARE:

1 Continuous slot	3 Mill slot	5 Gauzed wrapped	8 Saw cut	11 None (open hole)
2 Louvered shutter	4 Key punched	6 Wire wrapped	9 Drilled holes	
		7 Torch cut	10 Other (specify)	

SCREEN-PERFORATED INTERVALS: From **20** ft. to **35** ft., From ft. to ft.

From ft. to ft., From ft. to ft.

GRAVEL PACK INTERVALS: From **18** ft. to **35** ft., From ft. to ft.

From ft. to ft., From ft. to ft.

6 GROUT MATERIAL:

1 Neat cement	2 Cement grout	3 Bentonite	4 Other
---------------	-----------------------	--------------------	---------

Grout Intervals: From **0** ft. to **2** ft., From **2** ft. to **18** ft., From ft. to ft.

What is the nearest source of possible contamination:

1 Septic tank	4 Lateral lines	7 Pit privy	10 Livestock pens	14 Abandoned water well
2 Sewer lines	5 Cess pool	8 Sewage lagoon	11 Fuel storage	15 Oil well/Gas well
3 Watertight sewer lines	6 Seepage pit	9 Feedyard	12 Fertilizer storage	16 Other (specify below)
			13 Insecticide storage	

Direction from well? How many feet?

FROM	TO	LITHOLOGIC LOG	FROM	TO	PLUGGING INTERVALS
0	1	Clay, silty, w/roots, wet, Dark Brown			
1	23	Silt, clayey, moist, w/caliche streaks, Brown			
23	26	Silt, sl. clayey, w/some fine sand, wet, Brown			
26	35	Silt, sandy to v. clayey, sl. odor, Gray			

MW3R, Tag # 00371801, Flushmount
Project Name: Offerle Coop
GeoCore # 1371, KDHE # U1 029 00755

7 CONTRACTOR'S OR LANDOWNER'S CERTIFICATION: This water well was **1** constructed, **2** reconstructed, or **3** plugged under my jurisdiction and was completed on (mo/day/year) **4/16/2007** and this record is true to the best of my knowledge and belief.
 Kansas Water Well Contractor's License No. **527** This Water Well Record was completed on (mo/day/yr) **4/20/2007** under the business name of **GeoCore, Inc.** by (signature)