


1 LOCATION OF WATER WELL: County: Ford Fraction: NE 1/4 SW 1/4 SW 1/4 Section Number: 17 Township Number: T 25 S Range Number: R 21 B/W

Distance and direction from nearest town or city street address of well if located within city? 10275 Commercial, Spearmint

2 WATER WELL OWNER: Offerle Co-op RR#, St. Address, Box #: P.O. Box 90 City, State, ZIP Code: Offerle, Kansas 67563 Board of Agriculture, Division of Water Resources Application Number:

3 LOCATE WELL'S LOCATION WITH AN "X" IN SECTION BOX:

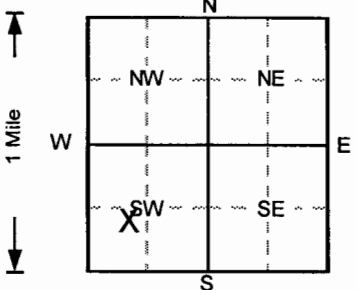

4 DEPTH OF COMPLETED WELL: 35 ft. ELEVATION:

Depth(s) Groundwater Encountered: 1. . . . . ft. 2. . . . . ft. 3. . . . . ft. WELL'S STATIC WATER LEVEL: 23 ft. below land surface measured on mo/day/yr: 4/17/2007. Pump test data: Well water was NA ft. after . . . . . hours pumping . . . . . gpm. Est. Yield: NA gpm. Well water was . . . . . ft. after . . . . . hours pumping . . . . . gpm. Bore Hole Diameter: 8 in. to 35 ft., and . . . . . in. to . . . . . ft. WELL WATER TO BE USED AS: 5 Public water supply 8 Air conditioning 11 Injection well 1 Domestic 3 Feedlot 6 Oil field water supply 9 Dewatering 12 Other (Specify below) 2 Irrigation 4 Industrial 7 Lawn and garden only 10 Monitoring well Water Well Disinfected? Yes No

5 TYPE OF BLANK CASING USED: 1 Steel 2 PVC 3 RMP (SR) 4 ABS 5 Wrought iron 6 Asbestos-Cement 7 Fiberglass 8 Concrete tile 9 Other (specify below) CASING JOINTS: Glued Clamped Welded Threaded

TYPE OF SCREEN OR PERFORATION MATERIAL: 1 Steel 2 Brass 3 Stainless steel 4 Galvanized steel 5 Fiberglass 6 Concrete tile 7 PVC 8 RMP (SR) 9 ABS 10 Asbestos-cement 11 Other (specify) 12 None used (open hole)

SCREEN OR PERFORATION OPENINGS ARE: 1 Continuous slot 2 Louvered shutter 3 Mill slot 4 Key punched 5 Gauzed wrapped 6 Wire wrapped 7 Torch cut 8 Saw cut 9 Drilled holes 10 Other (specify) 11 None (open hole)

SCREEN-PERFORATED INTERVALS: From 20 ft. to 35 ft. GRAVEL PACK INTERVALS: From 18 ft. to 35 ft.

6 GROUT MATERIAL: 1 Neat cement 2 Cement grout 3 Bentonite 4 Other Grout Intervals: From 0 ft. to 2 ft. From 2 ft. to 18 ft. What is the nearest source of possible contamination: 1 Septic tank 2 Sewer lines 3 Watertight sewer lines 4 Lateral lines 5 Cess pool 6 Seepage pit 7 Pit privy 8 Sewage lagoon 9 Feedyard 10 Livestock pens 11 Fuel storage 12 Fertilizer storage 13 Insecticide storage 14 Abandoned water well 15 Oil well/Gas well 16 Other (specify below)

Direction from well? FROM TO LITHOLOGIC LOG FROM TO PLUGGING INTERVALS

Table with 4 columns: FROM, TO, LITHOLOGIC LOG, FROM, TO, PLUGGING INTERVALS. Rows show depth intervals (0-1.5, 1.5-12, 12-20.5, 20.5-35) and lithology (Clay, silty, w/roots, dry, Dark Brown; Silt, clayey, moist, Brown; Silt, sl. clayey, dry, w/caliche, Brown; Silt, clayey, moist, wet @23', Tan). Includes MW6R, Tag # 00371818, Flushmount; Project Name: Offerle Coop; GeoCore # 1371, KDHE # U1 029 00755.

7 CONTRACTOR'S OR LANDOWNER'S CERTIFICATION: This water well was (1) constructed, (2) reconstructed, or (3) plugged under my jurisdiction and was completed on (mo/day/year) 4/17/2007 and this record is true to the best of my knowledge and belief. Kansas Water Well Contractor's License No. 527. This Water Well Record was completed on (mo/day/yr) 4/20/2007 under the business name of GeoCore, Inc. by (signature) Dale Kell