


1 LOCATION OF WATER WELL: Fraction C/N 1/2 1/4 SW 1/4 SE 1/4 Section Number 36 Township Number T 25 S Range Number R 21 E/W

County: Ford Distance and direction from nearest town or city street address of well if located within city?  
 3 1/2 east, 2 1/4 north of Windhorst, Ks.

2 WATER WELL OWNER: Pickrell Drilling  
 RR#, St. Address, Box #: Box 1303 Board of Agriculture, Division of Water Resources  
 City, State, ZIP Code: Great Bend, Ks. 67530 Application Number: 940063

3 LOCATE WELL'S LOCATION WITH AN "X" IN SECTION BOX:

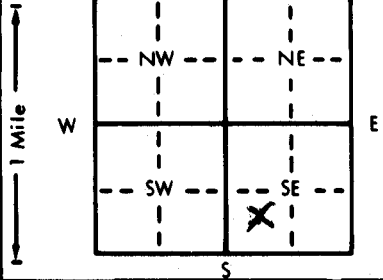

4 DEPTH OF COMPLETED WELL: 80 ft. ELEVATION:  
 Depth(s) Groundwater Encountered: 1 ft. 2. ft. 3. ft.  
 WELL'S STATIC WATER LEVEL: 81/99/NA ft. below land surface measured on mo/day/yr  
 Pump test data: Well water was ... ft. after ... hours pumping ... gpm  
 Est. Yield ... gpm: Well water was ... ft. after ... hours pumping ... gpm  
 Bore Hole Diameter: 10 in. to 80 ft., and ... in. to ... ft.  
 WELL WATER TO BE USED AS:  
 5 Public water supply 8 Air conditioning 11 Injection well  
 1 Domestic 3 Feedlot 6 Oil field water supply 9 Dewatering 12 Other (Specify below)  
 2 Irrigation 4 Industrial 7 Lawn and garden only 10 Monitoring well  
 Was a chemical/bacteriological sample submitted to Department? Yes ... No ...  
 Water Well Disinfected? Yes hth No

5 TYPE OF BLANK CASING USED:  
 1 Steel 3 RMP (SR) 5 Wrought iron 8 Concrete tile CASING JOINTS: Glued ... Clamped ...  
 2 PVC 4 ABS 7 Fiberglass 9 Other (specify below) Welded ...  
 Blank casing diameter: 99/1/2/NA in. to ... ft., Dia ... in. to ... ft., Dia ... in. to ... ft.  
 Casing height above land surface: 36 in., weight ... lbs./ft. Wall thickness or gauge No. ...

TYPE OF SCREEN OR PERFORATION MATERIAL:  
 1 Steel 3 Stainless steel 5 Fiberglass 7 PVC 10 Asbestos-cement  
 2 Brass 4 Galvanized steel 6 Concrete tile 8 RMP (SR) 11 Other (specify) NA  
 9 ABS 12 None used (open hole)

SCREEN OR PERFORATION OPENINGS ARE:  
 1 Continuous slot 3 Mill slot 5 Gauzed wrapped 8 Saw cut 11 None (open hole)  
 2 Louvered shutter 4 Key punched 6 Wire wrapped 9 Drilled holes NA  
 7 Torch cut 10 Other (specify) NA

SCREEN-PERFORATED INTERVALS: From ... ft. to ... ft., From ... ft. to ... ft.  
 GRAVEL PACK INTERVALS: From ... ft. to ... ft., From ... ft. to ... ft.

6 GROUT MATERIAL: 1 Neat cement 2 Cement grout 3 Bentonite 4 Other ...  
 Grout Intervals: From 80 ft. to 0 ft., From ... ft. to ... ft., From ... ft. to ... ft.  
 What is the nearest source of possible contamination:  
 1 Septic tank 4 Lateral lines 7 Pit privy 10 Livestock pens 14 Abandoned water well  
 2 Sewer lines 5 Cess pool 8 Sewage lagoon 11 Fuel storage 15 Oil well/Gas well  
 3 Watertight sewer lines 6 Seepage pit 9 Feedyard 12 Fertilizer storage 16 Other (specify below)  
 13 Insecticide storage NONE

Direction from well?		LITHOLOGIC LOG		PLUGGING INTERVALS	
FROM	TO	FROM	TO	FROM	TO
0	3				
3	21				
21	35				
35	41				
41	53				
53	66				
66	80				
		this was a dry hole, plugged with sand and gravel to 80' to 20' hole plug 20' to 0' ground level			

7 CONTRACTOR'S OR LANDOWNER'S CERTIFICATION: This water well was (1) constructed, (2) reconstructed, or (3) plugged under my jurisdiction and was completed on (mo/day/year) 3-14-94 and this record is true to the best of my knowledge and belief. Kansas Water Well Contractor's License No. 134 This Water Well Record was completed on (mo/day/yr) 3-18-94 under the business name of Rosencrantz-Bemis by (signature) Fredie Radson

INSTRUCTIONS: Use typewriter or ball point pen. PLEASE PRESS FIRMLY and PRINT clearly. Please fill in blanks, underline or circle the correct answers. Send top three copies to Kansas Department of Health and Environment, Bureau of Water, Topeka, Kansas 66620-0001. Telephone: 913-296-5545. Send one to WATER WELL OWNER and retain one for your records.