


1 LOCATION OF WATER WELL: County: Ford Fraction: 00 1/4 SE 1/4 SE 1/4 Section Number: 24 Township Number: T 25 S Range Number: R 21W

Distance and direction from nearest town or city street address of well if located within city?
5 E, 1 1/2 S of Bellefont, Kansas

2 WATER WELL OWNER: Earl Fields Abercrombie RTD Fields #1
RR#, St. Address, Box #: Hays, Kansas 150 N Main, #801 Board of Agriculture, Division of Water Resources
City, State, ZIP Code: 67601 Wichita, Kansas 67202-1383 Application Number: 950024

3 LOCATE WELL'S LOCATION WITH AN "X" IN SECTION BOX:

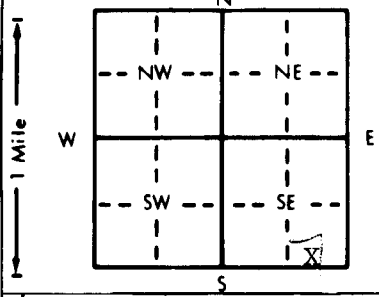

4 DEPTH OF COMPLETED WELL: 193 ft. ELEVATION: Unknown
Depth(s) Groundwater Encountered: 1. 65 ft. 2. ft. 3. ft.
WELL'S STATIC WATER LEVEL: 65 ft. below land surface measured on mo/day/yr: 1/20/95
Pump test data: Well water was ft. after hours pumping gpm
Est. Yield: 60 gpm: Well water was ft. after hours pumping gpm
Bore Hole Diameter: 7 7/8 in. to 193 ft., and in. to ft.
WELL WATER TO BE USED AS:
1 Domestic 3 Feedlot 6 Oil field water supply 9 Dewatering 12 Other (Specify below)
2 Irrigation 4 Industrial 7 Lawn and garden only 10 Monitoring well
Was a chemical/bacteriological sample submitted to Department? Yes No; If yes, mo/day/yr sample was submitted
Water Well Disinfected? Yes No

5 TYPE OF BLANK CASING USED:
1 Steel 3 RMP (SR) 5 Wrought iron 8 Concrete tile CASING JOINTS: Glued Clamped
2 PVC 4 ABS 6 Asbestos-Cement 9 Other (specify below) Welded
Blank casing diameter: 5 in. to 133 ft., Dia. in. to ft., Dia. in. to ft.
Casing height above land surface: 12 in., weight: 2.8 lbs./ft. Wall thickness or gauge No. Sch. 40
TYPE OF SCREEN OR PERFORATION MATERIAL:
1 Steel 3 Stainless steel 5 Fiberglass 7 PVC 10 Asbestos-cement
2 Brass 4 Galvanized steel 6 Concrete tile 8 RMP (SR) 11 Other (specify)
SCREEN OR PERFORATION OPENINGS ARE:
1 Continuous slot 3 Mill slot 5 Gauzed wrapped 8 Saw cut 11 None (open hole)
2 Louvered shutter 4 Key punched 6 Wire wrapped 9 Drilled holes
3 Torch cut 10 Other (specify)

SCREEN-PERFORATED INTERVALS: From 133 ft. to 193 ft., From ft. to ft.
GRAVEL PACK INTERVALS: From 20 ft. to 193 ft., From ft. to ft.

6 GROUT MATERIAL: 1 Neat cement 2 Cement grout 3 Bentonite 4 Other
Grout Intervals: From 0 ft. to 20 ft., From ft. to ft., From ft. to ft.
What is the nearest source of possible contamination:
1 Septic tank 4 Lateral lines 7 Pit privy 10 Livestock pens 14 Abandoned water well
2 Sewer lines 5 Cess pool 8 Sewage lagoon 11 Fuel storage 15 Oil well/Gas well
3 Watertight sewer lines 6 Seepage pit 9 Feedyard 12 Fertilizer storage 16 Other (specify below)
13 Insecticide storage
Direction from well? South How many feet? 60

FROM	TO	LITHOLOGIC LOG	FROM	TO	PLUGGING INTERVALS
0	3	Top soil			
3	133	Clay			
133	193	Sand rock			

7 CONTRACTOR'S OR LANDOWNER'S CERTIFICATION: This water well was (1) constructed, (2) reconstructed, or (3) plugged under my jurisdiction and was completed on (mo/day/year) 1/20/95 and this record is true to the best of my knowledge and belief. Kansas Water Well Contractor's License No. 186 This Water Well Record was completed on (mo/day/yr) 1/23/95 under the business name of Kelly's Water Well Service, Inc. by (signature) Steve Good

INSTRUCTIONS: Use typewriter or ball point pen. PLEASE PRESS FIRMLY and PRINT clearly. Please fill in blanks, underline or circle the correct answers. Send top three copies to Kansas Department of Health and Environment, Bureau of Water, Topeka, Kansas 66620-0001. Telephone: 913-296-5545. Send one to WATER WELL OWNER and retain one for your records.