


1 LOCATION OF WATER WELL: Fraction NE 1/4 SE 1/4 NE 1/4 Section Number 1 Township Number T 25 S Range Number R 22 E/W  
 County: FORD

Distance and direction from nearest town or city street address of well if located within city?  
4 E 3 1/2 N. Spearville Kansas

2 WATER WELL OWNER: Biles Ranch Board of Agriculture, Division of Water Resources  
 RR#, St. Address, Box #: Bucklin Kansas Application Number:  
 City, State, ZIP Code:

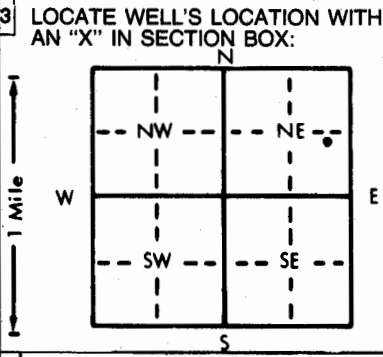

4 DEPTH OF COMPLETED WELL: 40 ft. ELEVATION:  
 Depth(s) Groundwater Encountered 1 ft. 14 ft. 14 ft. 14 ft. 14 ft.  
 WELL'S STATIC WATER LEVEL 14 ft. below land surface measured on mo/day/yr 3-13-84  
 Pump test data: Well water was 14 ft. after 1 hours pumping 3 gpm  
 Est. Yield 10 gpm: Well water was 14 ft. after 1 hours pumping 3 gpm  
 Bore Hole Diameter 8 3/4 in. to 40 ft., and 40 in. to 40 ft.  
 WELL WATER TO BE USED AS:  
 Domestic  3 Feedlot  6 Oil field water supply  9 Dewatering  12 Other (Specify below)  
 2 Irrigation  4 Industrial  7 Lawn and garden only  10 Observation well  
 Was a chemical/bacteriological sample submitted to Department? Yes X No X; If yes, mo/day/yr sample was submitted  
 Water Well Disinfected? Yes X No X

5 TYPE OF BLANK CASING USED:  
 1 Steel  3 RMP (SR)  5 Wrought iron  8 Concrete tile  CASING JOINTS: Glued X Clamped X  
 2 PVC  4 ABS  6 Asbestos-Cement  9 Other (specify below)  Welded   
 7 Fiberglass  Threaded   
 Blank casing diameter 5 in. to 20 ft., Dia 20 in. to 20 ft., Dia 20 in. to 20 ft.  
 Casing height above land surface 16 in., weight SDR-26 lbs./ft. Wall thickness or gauge No. SDR-26  
 TYPE OF SCREEN OR PERFORATION MATERIAL:  
 1 Steel  3 Stainless steel  5 Fiberglass  7 PVC  10 Asbestos-cement   
 2 Brass  4 Galvanized steel  6 Concrete tile  8 RMP (SR)  11 Other (specify)   
 9 ABS  12 None used (open hole)   
 SCREEN OR PERFORATION OPENINGS ARE:  
 1 Continuous slot  3 Mill slot  5 Gauzed wrapped  8 Saw cut  11 None (open hole)   
 2 Louvered shutter  4 Key punched  6 Wire wrapped  9 Drilled holes   
 7 Torch cut  10 Other (specify)   
 SCREEN-PERFORATED INTERVALS: From 20 ft. to 40 ft., From 20 ft. to 40 ft., From 20 ft. to 40 ft.  
 GRAVEL PACK INTERVALS: From 10 ft. to 40 ft., From 10 ft. to 40 ft., From 10 ft. to 40 ft.

6 GROUT MATERIAL:  Neat cement  2 Cement grout  3 Bentonite  4 Other   
 Grout Intervals: From 0 ft. to 10 ft., From 0 ft. to 10 ft., From 0 ft. to 10 ft., From 0 ft. to 10 ft.  
 What is the nearest source of possible contamination:  
 1 Septic tank  4 Lateral lines  7 Pit privy  10 Livestock pens  14 Abandoned water well   
 2 Sewer lines  5 Cess pool  8 Sewage lagoon  11 Fuel storage  15 Oil well/Gas well   
 3 Watertight sewer lines  6 Seepage pit  9 Feedyard  12 Fertilizer storage  16 Other (specify below) PASTURE  
 13 Insecticide storage

Direction from well? \_\_\_\_\_ How many feet? \_\_\_\_\_

FROM	TO	LITHOLOGIC LOG	FROM	TO	LITHOLOGIC LOG
0	1	Top Soil			
1	4	Tan Clay			
4	6	Sandy Clay			
6	14	Tan Clay			
14	16	Sand			
16	24	Tan Clay			
24	26	GRAVEL			
26	30	Tan Clay			
30	40	Shale			

7 CONTRACTOR'S OR LANDOWNER'S CERTIFICATION: This water well was (1) constructed, (2) reconstructed, or (3) plugged under my jurisdiction and was completed on (mo/day/year) 3-13-84 and this record is true to the best of my knowledge and belief. Kansas  
 Water Well Contractor's License No. 224 This Water Well Record was completed on (mo/day/yr) 7-31-84  
 under the business name of Carl Hayes Water Well Sew., by (signature) Carl Hayes  
 INSTRUCTIONS: Use typewriter or ball point pen, PLEASE PRESS FIRMLY and PRINT clearly. Please fill in blanks, underline or circle the correct answers. Send top three copies to Kansas Department of Health and Environment, Division of Environment, Environmental Geology Section, Topeka, KS 66620. Send one to WATER WELL OWNER and retain one for your records.

OFFICE USE ONLY