

USE TYPEWRITER OR BALL POINT PEN-PRESS FIRMLY, PRINT CLEARLY.

SPEARVILLE NE


WATER WELL RECORD
KSA 82a-1201-1215

Kansas Department of Health and Environment-Division of Environment (Water well Contractors) Topeka, Kansas 66620

BTBA

1. Location of well: County **Ford** Fraction **SE NW NW** Section number **6** Township number **25** Range number **22**
Center NW 1/4 1/4 1/4

2. Distance and direction from nearest town or city: **3 north-2 west-3/4 north-1/4 west of Spearville**
 3. Owner of well: **Lloyd Cole**
 R.R. or street: **Jetmore, Kansas**
 City, state, zip code:

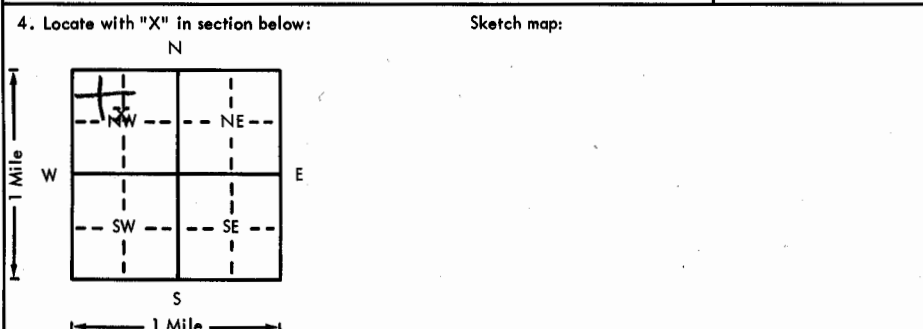

6. Bore hole dia. 26 in. Completion date _____
 Well depth 345 ft. 3-20-78
 7. Cable tool Rotary Driven Dug
 Hollow rod Jetted Bored Reverse rotary
 8. Use: Domestic Public supply Industry
 Irrigation Air conditioning Stock
 Lawn Oil field water Other
 9. Casing: Material metal Height: Above or below
 Threaded Welded Surface 10 in.
 RMP PVC Weight 31.66 lbs./ft.
 Dia. 16 in. to 345 ft. depth Wall Thickness: inches or
 Dia. 16 in. to 345 ft. depth gage No. 188

5. Type and color of material	From	To
Surface	0	3
Brown clay	3	35
Tan coleche clay	35	70
Coarse sand and gravel	70	90
Yellow clay	90	95
Blue & gray shale with rock layers	95	195
Extra hard rock	195	196
Gray shale	196	203
Tan sandstone with 15% shale mixed	203	230
Gray shale	230	234
Good A-1 tan sandstone	234	342
Gray shale with hard rock layers	342	405
<i>BR20K 190'</i>		
<i>CRETACEOUS WELL</i>		

10. Screen: Manufacturer's name W.A. Brown
 Type 10% Freq-flo Dia. 16
 Slot/gauze 1/8 Length 160
 Set between 72-92 ft. and 205-345 ft.
 Gravel pack? yes Size range of material 1/2 down
 11. Static water level: _____ mo./day/yr.
215 ft. below land surface Date 12-13-77
 12. Pumping level below land surfaces:
 _____ ft. after _____ hrs. pumping _____ g.p.m.
 _____ ft. after _____ hrs. pumping _____ g.p.m.
 Estimated maximum yield 700 g.p.m.
 13. Water sample submitted: _____ mo./day/yr.
 Yes No Date _____
 14. Well head completion:
 Pitless adapter _____ Inches above grade
 15. Well grouted? yes
 With: Neat cement Bentonite Concrete
 Depth: From 0 ft. to 10 ft.
 16. Nearest source of possible contamination: field
 ft. _____ Direction _____ Type _____
 Well disinfected upon completion? Yes No
 17. Pump: Not installed
 Manufacturer's name _____
 Model number _____ HP _____ Volts _____
 Length of drop pipe _____ ft. capacity _____ g.p.m.
 Type:
 Submersible Turbine
 Jet Reciprocating
 Centrifugal Other

18. Elevation: _____ 19. Remarks: _____
 Topography:
 Hill
 Slope
 Upland
 Valley
 20. Water well contractor's certification:
 This well was drilled under my jurisdiction and this report is true to the best of my knowledge and belief.
Ace-Hi International 190
 Business name License No. _____
 Address **Dodge City, Kansas**
 Signed Carl C. Little Date 3-20-78
 Authorized representative

25-220-6-1/4 1/4 1/4