


1 LOCATION OF WATER WELL: Fraction Section Number Township Number Range Number  
 COUNTY: FORD NE 1/4 SE 1/4 SW 1/4 26 T 26 S R 22 E

Distance and direction from nearest town or city street address of well if located within city?  
 FROM SPEARVILLE ON RD 126 - EAST TO 129 RD 1 1/2S & 1/2 W

2 WATER WELL OWNER: HAIN, HENRY  
 RR#, St. Address, Box #: MANOR OF THE PLAINS Board of Agriculture, Division of Water Resources  
 City, State, ZIP code: DODGE CITY, KS 67801- Application Number:

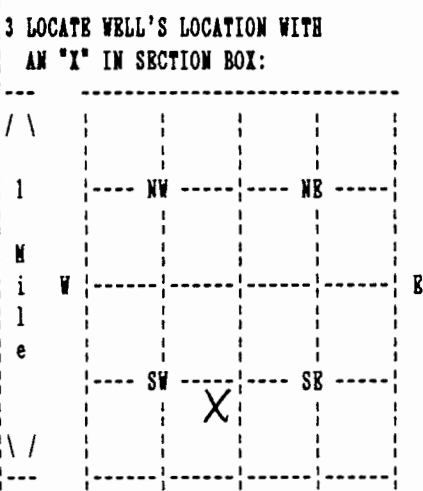

4 DEPTH OF COMPLETED WELL 208 ELEVATION: 0  
 Depth(s) Groundwater Encountered 1. 0 ft. 2. 0 ft. 3. 0 ft.  
 WELL'S STATIC WATER LEVEL 24 ft. below land surface measured on mo/day/yr 07/19/06  
 Pump testdata: Well water was 0 ft. after 0 hours pumping 0 gpm  
 Estimated Yield 60 gpm: Well water was 0 ft. after 0 hours pumping 0 gpm  
 Bore Hole Diameter 9 in. to 208 ft., and in. to 0 ft.  
 WELL WATER TO BE USED AS: DOMESTIC  
 Was a chemical/bacteriological sample submitted to department? No ;  
 If yes, mo/day/yr sample was submitted Water well disinfected? Yes

5 TYPE OF BLANK CASING USED: CERTA LOC CASIN CASING JOINTS: CERTA-LOC  
 Blank casing diameter 5 in. to 208 ft., Dia in. to 0 ft., Dia in. to 0 ft.  
 Casing height above land surface 36 in., weight 200 lbs/ft. Wall thickness or gauge No. 21  
 TYPE OF SCREEN OR PERFORATION MATERIAL: PVC  
 SCREEN OR PERFORATION OPENINGS ARE: SAW CUT

SCREEN PERFORATED INTERVALS: From 140 ft. to 200 ft., From 0 ft. to 0 ft.  
 From 0 ft. to 0 ft., From 0 ft. to 0 ft.  
 GRAVEL PACK INTERVALS: From 20 ft. to 208 ft., From 0 ft. to 0 ft.  
 From 0 ft. to 0 ft., From 0 ft. to 0 ft.

6 GROUT MATERIAL BENTONITE  
 Grout Intervals: From 0 ft. to 20 ft., From 0 ft. to 0 ft., From 0 ft. to 0 ft.  
 What is the nearest source of possible contamination: NONE  
 Direction from well? How many feet? 0

FROM	TO	LITHOLOGIC LOG	FROM	TO	PLUGGING INTERVALS
0	20	01 TOPSOIL 05 CLAY 02 FINE SAND			
20	40	02 FINE SAND 36 BLUE CLAY 16 GRAY CLAY			
40	60	16 GRAY CLAY 37 PIN-COAR SAN 32 TAN CLAY			
60	80	32 TAN CLAY			
80	100	16 GRAY CLAY 36 BLUE CLAY			
100	120	16 GRAY CLAY 36 BLUE CLAY 29 SANDSTONE			
120	160	29 SANDSTONE (white)			
160	180	29 SANDSTONE 40 TAN SANDSTON (white)			
180	200	29 SANDSTONE (white)			
200	220	29 SANDSTONE 16 GRAY CLAY (white)			

7 CONTRACTOR'S OR LANDOWNER'S CERTIFICATION: This water well was Constructed under my jurisdiction and was completed on (mo/day/year) 07/19/06 and this record is true to the best of my knowledge and belief. Kansas Water Well Contractor's License No. 179 This Water Well Record was completed on (mo/day/yr) 07/26/06 under the business name of JOB'S WELL SERVICE, INC. by (signature) *Janet Cuit*