


1 LOCATION OF WATER WELL: County: <u>Ford</u>	Fraction <u>NW 1/4 NW 1/4 SE 1/4</u>	Section Number <u>1</u>	Township Number <u>T 25 S</u>	Range Number <u>R 23</u> EW
--	---	----------------------------	----------------------------------	---------------------------------------

Distance and direction from nearest town or city street address of well if located within city?
 From Spearville, Ks. - 5 miles North on blacktop, 2 miles West and 1/2 mile North

2 WATER WELL OWNER: Raymond Weßel
 RR#, St. Address, Box # : Box 1149 Board of Agriculture, Division of Water Resources
 City, State, ZIP Code : Dodge City, Kansas 67801 Application Number:

3 LOCATE WELL'S LOCATION WITH AN "X" IN SECTION BOX:

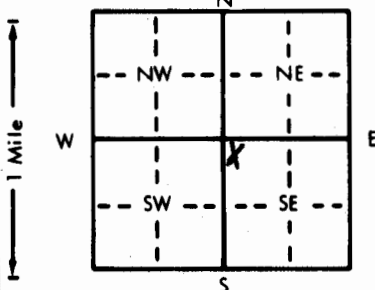

4 DEPTH OF COMPLETED WELL... 285 ft. ELEVATION:

Depth(s) Groundwater Encountered 1. ft. 2. ft. 3. ft.
 WELL'S STATIC WATER LEVEL ... 145 ft. below land surface measured on mo/day/yr ... 4-11-90
 Pump test data: Well water was ft. after hours pumping gpm
 Est. Yield ... 35 gpm: Well water was ft. after hours pumping gpm
 Bore Hole Diameter ... 10 in. to ... 285 ft., and in. to ft.
 WELL WATER TO BE USED AS: 5 Public water supply 8 Air conditioning 11 Injection well
 1 Domestic 3 Feedlot 6 Oil field water supply 9 Dewatering 12 Other (Specify below)
 2 Irrigation 4 Industrial 7 Lawn and garden only 10 Monitoring well
 Was a chemical/bacteriological sample submitted to Department? Yes.....No...XX.....; If yes, mo/day/yr sample was sub-
 mitted Water Well Disinfected? Yes XX No

5 TYPE OF BLANK CASING USED: 5 Wrought iron 8 Concrete tile CASING JOINTS: Glued ...XX... Clamped
 1 Steel 3 RMP (SR) 6 Asbestos-Cement 9 Other (specify below) Welded
 2 PVC 4 ABS 7 Fiberglass Threaded

Blank casing diameter ... 5 in. to ... 285 ft., Dia in. to ft., Dia in. to ft.
 Casing height above land surface ... 12 in., weight ... 200 psi lbs./ft. Wall thickness or gauge No. SDR 21

TYPE OF SCREEN OR PERFORATION MATERIAL: 7 PVC 10 Asbestos-cement
 1 Steel 3 Stainless steel 5 Fiberglass 8 RMP (SR) 11 Other (specify)
 2 Brass 4 Galvanized steel 6 Concrete tile 9 ABS 12 None used (open hole)

SCREEN OR PERFORATION OPENINGS ARE: 5 Gauzed wrapped 8 Saw cut 11 None (open hole)
 1 Continuous slot 3 Mill slot 6 Wire wrapped 9 Drilled holes
 2 Louvered shutter 4 Key punched 7 Torch cut 10 Other (specify)

SCREEN-PERFORATED INTERVALS: From ... 240 ft. to ... 280 ft., From ft. to ft.
 From ft. to ft., From ft. to ft.
 GRAVEL PACK INTERVALS: From ... 45 ft. to ... 285 ft., From ft. to ft.
 From ft. to ft., From ft. to ft.

6 GROUT MATERIAL: 1 Neat cement 2 Cement grout 3 Bentonite 4 Other ... hole plug
 Grout Intervals: From ... 0 ft. to ... 45 ft., From ft. to ft., From ft. to ft.

What is the nearest source of possible contamination: none - new site 10 Livestock pens 14 Abandoned water well
 1 Septic tank 4 Lateral lines 7 Pit privy 11 Fuel storage 15 Oil well/Gas well
 2 Sewer lines 5 Cess pool 8 Sewage lagoon 12 Fertilizer storage 16 Other (specify below)
 3 Watertight sewer lines 6 Seepage pit 9 Feedyard 13 Insecticide storage

Direction from well?		LITHOLOGIC LOG		PLUGGING INTERVALS	
FROM	TO	FROM	TO	FROM	TO
0	20				
		Top soil (3 ft.), claichie, fine sand, claichie and blue shale			
20	100				
		Blue shale			
100	120				
		Gray Clay & rock layers			
120	140				
		Gray clay, brown sand stone and gray clay in layers			
140	160				
		Gray clay & sand stone			
160	300				
		Dakota sand stone			

7 CONTRACTOR'S OR LANDOWNER'S CERTIFICATION: This water well was (1) constructed, (2) reconstructed, or (3) plugged under my jurisdiction and was completed on (mo/day/year) ... 4-11-90 ... and this record is true to the best of my knowledge and belief. Kansas Water Well Contractor's License No. ... 179 ... This Water Well Record was completed on (mo/day/yr) ... 4-16-90 ... under the business name of Joe's Well Service, Inc. Cimarron, Ks. by (signature) Julith Creek