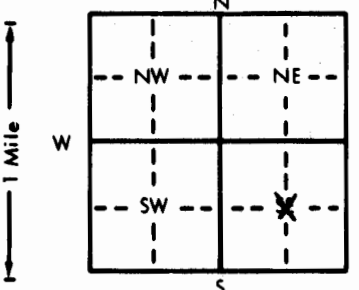


1 LOCATION OF WATER WELL: Fraction $\frac{1}{4}$ C $\frac{1}{4}$ SE $\frac{1}{4}$ Section Number 13 Township Number T 25 S Range Number R 23 EW
 County: Ford Distance and direction from nearest town or city street address of well if located within city?

1 1/4 North, 2 1/4 West of Spearville

2 WATER WELL OWNER: John Indiek Board of Agriculture, Division of Water Resources
 RR#, St. Address, Box #: Rt.1 Box 62 Application Number:
 City, State, ZIP Code: Offerle, Ks. 67563

3 LOCATE WELL'S LOCATION WITH AN "X" IN SECTION BOX:  DEPTH OF COMPLETED WELL: .65 ft. ELEVATION:
 Depth(s) Groundwater Encountered 1. ft. 2. ft. 3. ft.
 WELL'S STATIC WATER LEVEL .30. ft. below land surface measured on mo/day/yr .2/1/89.
 Pump test data: Well water was ft. after hours pumping gpm
 Est. Yield . . . NA . gpm: Well water was ft. after hours pumping gpm
 Bore Hole Diameter. . .10. . .in. to65. . .ft., and.in. toft.
 WELL WATER TO BE USED AS: 5 Public water supply 8 Air conditioning 11 Injection well
 1 Domestic 3 Feedlot 6 Oil field water supply 9 Dewatering 12 Other (Specify below)
 2 Irrigation 4 Industrial 7 Lawn and garden only 10 Monitoring well
 Was a chemical/bacteriological sample submitted to Department? Yes. No. X.; If yes, mo/day/yr sample was sub-
 mitted Water Well Disinfected? Yes HTH No

5 TYPE OF BLANK CASING USED: 5 Wrought iron 8 Concrete tile CASING JOINTS: Glued X . . Clamped
 1 Steel 3 RMP (SR) 6 Asbestos-Cement 9 Other (specify below) Welded
 2 PVC 4 ABS 7 Fiberglass Threaded.
 Blank casing diameter . .5.in. to35.ft., Diain. toft., Diain. toft.
 Casing height above land surface. . .18.in., weight258. lbs./ft. Wall thickness or gauge No.
 TYPE OF SCREEN OR PERFORATION MATERIAL: 7 PVC 10 Asbestos-cement
 1 Steel 3 Stainless steel 5 Fiberglass 8 RMP (SR) 11 Other (specify)
 2 Brass 4 Galvanized steel 6 Concrete tile 9 ABS 12 None used (open hole)
 SCREEN OR PERFORATION OPENINGS ARE: 5 Gauzed wrapped 8 Saw cut 11 None (open hole)
 1 Continuous slot 3 Mill slot 6 Wire wrapped 9 Drilled holes
 2 Louvered shutter 4 Key punched 7 Torch cut 10 Other (specify)
 SCREEN-PERFORATED INTERVALS: From35.ft. to65.ft., Fromft. toft.
 Fromft. toft., Fromft. toft.
 GRAVEL PACK INTERVALS: From20.ft. to65.ft., Fromft. toft.
 Fromft. toft., Fromft. toft.

6 GROUT MATERIAL: 1 Neat cement 2 Cement grout 3 Bentonite 4 Other
 Grout Intervals: From . .0.ft. to20.ft., Fromft. toft., Fromft. toft.
 What is the nearest source of possible contamination:
 1 Septic tank 4 Lateral lines 7 Pit privy 10 Livestock pens 14 Abandoned water well
 2 Sewer lines 5 Cess pool 8 Sewage lagoon 11 Fuel storage 15 Oil well/Gas well
 3 Watertight sewer lines 6 Seepage pit 9 Feedyard 12 Fertilizer storage 16 Other (specify below)
 13 Insecticide storage
 Direction from well? Southeast How many feet? 80

| FROM | TO | LITHOLOGIC LOG | FROM | TO | PLUGGING INTERVALS |
|------|----|------------------------|------|----|--------------------|
| 0 | 3 | Top Soil | | | |
| 3 | 12 | Clay | | | |
| 12 | 21 | clay with white rock | | | |
| 21 | 26 | Fine Sand | | | |
| 26 | 32 | Sandy Clay | | | |
| 32 | 40 | Fine Sand W/Clay Mixed | | | |
| 40 | 45 | Clay | | | |
| 45 | 62 | Clay with Sand mixed | | | |
| 62 | 65 | Shale | | | |

7 CONTRACTOR'S OR LANDOWNER'S CERTIFICATION: This water well was (1) constructed, (2) reconstructed, or (3) plugged under my jurisdiction and was completed on (mo/day/year) .2/1/89. and this record is true to the best of my knowledge and belief. Kansas Water Well Contractor's License No. .134. This Water Well Record was completed on (mo/day/yr) .6/20/89. under the business name of Rosencrantz-Bemis by (signature) *Indiek*