USE TYPEWRITER OR BALL POINT PEN-PRESS FIRMLY, PRINT CLEARLY.

SPEARVILLE NE

WATER WELL RECORD
KSA 82a-1201-1215

T		R		EW		sec	1/4	1/4	1/4	No.

Kansas State Dept. Of Health
(Water Well Contractors)
Forbes-Bldg. 740
Topeka, Kansas 66620

1 Location of well:	County	Township name	Fraction	Section number	Town number	Range number
	Ford	Spearville	NW¼ NW¼ 13	13	T-25	R-23-W

Distance and direction from nearest town or city:
2½ west and 2 north of Spearville, Kansas

Street address of well location if in city:

3 Owner of well: Donald Stein

Address: Dodge City, Kansas

Locate with "X" in section below:

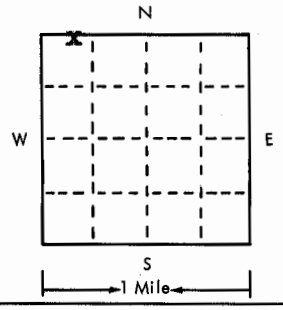

Sketch map:

4 Well depth: 373 ft. Date of completion 9-7-74
Well diameter 28 in.

5 ☐ Cable tool ☐ Rotary ☐ Driven ☐ Dug
☐ Hollow rod ☐ Jetted ☐ Bored ☒ Reverse rotary

6 Use: ☐ Domestic ☐ Public supply ☐ Industry
☒ Irrigation ☐ Air conditioning ☐ Commercial
☐ Test well ☐ _____

7 Casing: Material _____ Height: above/below
Threaded ☐ Welded ☐ Surface ____ in.
Diam. Weight ____ lbs./ft.
____ in. to ____ ft. depth Drive shoe? ☐ Yes ☐ No
____ in. to ____ ft. depth

2 Type and color of material	From	To
(use a second sheet if needed)		

8 Screen:
Manufacturer _____
Type _____ Dia. _____
Slot/gauze _____ Length _____
Set between ____ ft. and ____ ft.
Fittings:
Gravel pack ☐ Yes ☐ No Size range of material ____

9 Static water level:
____ ft. below land surface Date ____

10 Pumping level below land surfaces:
250 ft. after 4 hrs. pumping 725 g.p.m.
258 ft. after 1 hrs. pumping 890 g.p.m.
Estimated maximum yield 1100 g.p.m.

11 Water sample submitted:
☐ Yes ☒ No Date ____

12 Well head completion:
☐ Pitless adapter ☐ Inches above grade

13 Well grouted? ☐ Yes ☒ No
☐ Neat cement ☐ Bentonite ☐ _____
Depth: From ____ ft. to ____ ft.

14 Nearest source of possible contamination: NA
ft. ____ Direction ____ Type ____
Well disinfected upon completion? ☐ Yes ☐ No

15 Pump: ☐ Not installed
Manufacturer's name Goulds Installed 3-6-75
Model number 12JMC HP 125 Volts ____
Length of drop pipe 300 ft. capacity 750 g.m.p.
Type:
☐ Submersible ☒ Turbine
☐ Jet ☐ Reciprocating
☐ Certrifugal ☐ Other

16 Remarks: elevation

Topography:
☐ Hill
☐ Slope
☒ Upland
☐ Valley

TOPO

2443

17 Water well contractor's certification:
This well was drilled under my jurisdiction and this report is true to the best of my knowledge and belief.
Ace-Hi Drilling Co 190
Business name License No.
Address Box 1442 - Dodge City, Ks.
Signed Carl G Little Date 3-12-75
Authorized representative

Forward the white, blue and pink copies to the Kansas State Dept. Of Health.

Form WWC-5