


WATER WELL RECORD Form WWC-5 KSA 82a-1212

1 LOCATION OF WATER WELL: COUNTY: FORD Fraction SW 1/4 SW 1/4 SE 1/4 Section Number 34 Township Number T 25 S Range Number R 23 W

Distance and direction from nearest town or city street address of well if located within city? 2 MILES SOUTH, 4 1/2 MILES WEST OF SPEARVILLE

2 WATER WELL OWNER: HUBBELL & HUBBELL RR#, St. Address, Box #: 10405 132 ROAD City, State, ZIP code: SPEARVILLE, KS 67876- Board of Agriculture, Division of Water Resources Application Number:

3 LOCATE WELL'S LOCATION WITH AN "X" IN SECTION BOX:

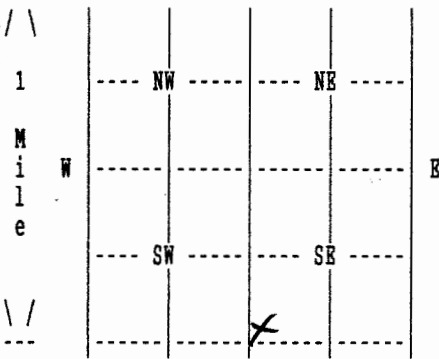

4 DEPTH OF COMPLETED WELL 100 ELEVATION: 0 Depth(s) Groundwater Encountered 1. 0 ft. 2. 0 ft. 3. 0 ft.

WELL'S STATIC WATER LEVEL 60 ft. below land surface measured on mo/day/yr 07/13/04 Pump test data: Well water was 0 ft. after 0 hours pumping 0 gpm

Estimated Yield 0 gpm: Well water was 0 ft. after 0 hours pumping 0 gpm

Bore Hole Diameter 8.75 in. to 100 ft., and in. to 0 ft.

WELL WATER TO BE USED AS: LIVESTOCK

Was a chemical/bacteriological sample submitted to department? No; If yes, mo/day/yr sample was submitted Water well disinfected? Yes

5 TYPE OF BLANK CASING USED: PVC CASING JOINTS: GLUED Blank casing diameter 5 in. to 60 ft., Dia in. to 0 ft., Dia in. to 0 ft. Casing height above land surface 18 in., weight 0 lbs/ft. Wall thickness or gauge No. 26 TYPE OF SCREEN OR PERFORATION MATERIAL: PVC SCREEN OR PERFORATION OPENINGS ARE: SAW CUT

SCREEN PERFORATED INTERVALS: From 60 ft. to 100 ft., From 0 ft. to 0 ft. From 0 ft. to 0 ft., From 0 ft. to 0 ft. GRAVEL PACK INTERVALS: From 24 ft. to 100 ft., From 0 ft. to 0 ft. From 0 ft. to 0 ft., From 0 ft. to 0 ft.

6 GROUT MATERIAL BENTONITE Grout Intervals: From 4 ft. to 24 ft., From 0 ft. to 0 ft., From 0 ft. to 0 ft. What is the nearest source of possible contamination: SEPTIC TANK Direction from well? SOUTH How many feet? 2700

Table with columns: FROM, TO, LITHOLOGIC LOG, FROM, TO, PLUGGING INTERVALS. Rows include: 0-4 BROWN CLAY, 4-36 TAN CLAY, 36-39 WHITE CLAY, 39-55 WHITE ROCK, 55-81 SANDY TAN CLAY, 81-86 GRAY CLAY, 86-92 BROWN SANDSTONE, 92-100 GRAY CLAY.

7 CONTRACTOR'S OR LANDOWNER'S CERTIFICATION: This water well was Constructed under my jurisdiction and was completed on (mo/day/year) 07/13/04 and this record is true to the best of my knowledge and belief. Kansas Water Well Contractor's License No. 653 This Water Well Record was completed on (mo/day/yr) 09/22/04 under the business name of DAN HAYSE WATER WELL SERV by (signature) Dan Hayse