


WATER WELL RECORD Form WWC-5 KSA 82a-1212

1 LOCATION OF WATER WELL: Fraction Section Number Township Number Range Number  
 COUNTY: FORD SE 1/4 SE 1/4 SE 1/4 16 T 25 S R 23 W

Distance and direction from nearest town or city street address of well if located within city?  
 ON 283 HIGHWAY NORTH TO EAGLE RD. 3 EAST TO 121 RD. 1 NORTH

2 WATER WELL OWNER: KELLER, GLEN  
 RR#, St. Address, Box #: 10299 121 ROAD Board of Agriculture, Division of Water Resources  
 City, State, ZIP code: SPEARVILLE, KS 67876- Application Number:

3 LOCATE WELL'S LOCATION WITH AN "X" IN SECTION BOX: 4 DEPTH OF COMPLETED WELL 323 ELEVATION: 0  
 Depth(s) Groundwater Encountered 1. 0 ft. 2. 0 ft. 3. 0 ft.

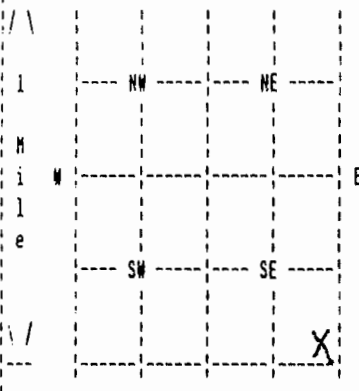

WELL'S STATIC WATER LEVEL 241 ft. below land surface measured on mo/day/yr 11/02/10  
 Pump test data: Well water was 0 ft. after 0 hours pumping 0 gpm  
 Estimated Yield 15 gpm: Well water was 0 ft. after 0 hours pumping 0 gpm  
 Bore Hole Diameter 9 in. to 323 ft., and in. to 0 ft.  
 WELL WATER TO BE USED AS: DOMESTIC  
 Was a chemical/bacteriological sample submitted to department? No ;  
 If yes, mo/day/yr sample was submitted Water well disinfected? Yes

5 TYPE OF BLANK CASING USED: CERTA LOC CASIN CASING JOINTS: CERTA-LOC  
 Blank casing diameter 5 in. to 323 ft., Dia in. to 0 ft., Dia in. to 0 ft.  
 Casing height above land surface 12 in., weight 200 lbs/ft. Wall thickness or gauge No. 21  
 TYPE OF SCREEN OR PERFORATION MATERIAL: PVC  
 SCREEN OR PERFORATION OPENINGS ARE: SAW CUT

SCREEN PERFORATED INTERVALS: From 160 ft. to 200 ft., From 0 ft. to 0 ft.  
 From 260 ft. to 320 ft., From 0 ft. to 0 ft.  
 GRAVEL PACK INTERVALS: From 25 ft. to 323 ft., From 0 ft. to 0 ft.  
 From 0 ft. to 0 ft., From 0 ft. to 0 ft.

6 GROUT MATERIAL BENTONITE  
 Grout Intervals: From 5 ft. to 25 ft., From 0 ft. to 0 ft., From 0 ft. to 0 ft.  
 What is the nearest source of possible contamination: ABANDONED WELL  
 Direction from well? NORTH How many feet? 15

FROM	TO	LITHOLOGIC LOG	FROM	TO	PLUGGING INTERVALS
0	20	01 TOPSOIL 35 CALACHIE 14 WHITE CLAY			
20	40	14 WHITE CLAY 35 CALACHIE 27 ROCK			
40	60	28 SAND 27 ROCK 02 FINE SAND			
60	80	02 FINE SAND 28 SAND 27 ROCK			
80	100	27 ROCK 16 GRAY CLAY			
100	120	27 ROCK			
120	140	27 ROCK 16 GRAY CLAY			
140	180	16 GRAY CLAY 29 SANDSTONE			
180	200	29 SANDSTONE			
200	220	29 SANDSTONE 16 GRAY CLAY			

7 CONTRACTOR'S OR LANDOWNER'S CERTIFICATION: This water well was Constructed under my jurisdiction and was completed on (mo/day/year) 11/03/10 and this record is true to the best of my knowledge and belief. Kansas Water Well Contractor's License No. 179 This Water Well Record was completed on (mo/day/yr) 11/23/10 under the business name of JOE'S WELL SERVICE, INC. by (signature) Judith Crick

(Continued)

WATER WELL RECORD Form WNC-5 KSA 82a-1212

1 LOCATION OF WATER WELL: Fraction Section Number Township Number Range Number  
COUNTY: FORD SE 1/4 SE 1/4 SE 1/4 16 T 25 S R 23 W

2 WATER WELL OWNER: KELLER, GLEN Board of Agriculture, Division of Water Resources  
RR#, St. Address, Box #: 10299 121 ROAD Application Number:  
City, State, ZIP code: SPEARVILLE, KS 67876-

FROM	TO	LITHOLOGIC LOG
220	240	16 GRAY CLAY
240	260	16 GRAY CLAY 29 SANDSTONE
260	280	29 SANDSTONE
280	300	29 SANDSTONE 08 ROCK LAYERS
300	320	29 SANDSTONE
320	340	29 SANDSTONE 16 GRAY CLAY
340	360	16 GRAY CLAY

7 CONTRACTOR'S OR LANDOWNER'S CERTIFICATION: This water well was Constructed under my jurisdiction and was completed on (mo/day/year) 11/03/10 and this record is true to the best of my knowledge and belief. Kansas Water Well Contractor's License No. 179 This Water Well Record was completed on (mo/day/yr) 11/23/10 under the business name of JOE'S WELL SERVICE, INC. by (signature) *Judith Crick*