

USE TYPEWRITER OR BALL POINT PEN-PRESS FIRMLY, PRINT CLEARLY.

WATER WELL RECORD
KSA 82a-1201-1215

ADD

SITING ONLY
NW


25 24 W 6 SE SE NE
T R EW sec 1/4 1/4 1/4 No.

Kansas State Dept. Of Health
(Water Well Contractors)
Forbes-Bldg. 740
Topeka, Kansas 66620

| | | | | | | |
|---------------------|-----------------------|-----------------------------------|--|-----------------------------|-------------------------------|--------------------------------|
| 1 Location of well: | County Ford | Township name Grandview | Fraction SESE NE$\frac{1}{4}$ | Section number #6 | Town number T #25 S | Range number R #24 W |
|---------------------|-----------------------|-----------------------------------|--|-----------------------------|-------------------------------|--------------------------------|

Distance and direction from nearest town or city: **9 miles north, 3 miles east of Dodge City, Ks.**
Street address of well location if in city:

3 Owner of well: **O.K. ECCLESTON**
Address: **Wright, Kansas 67882**

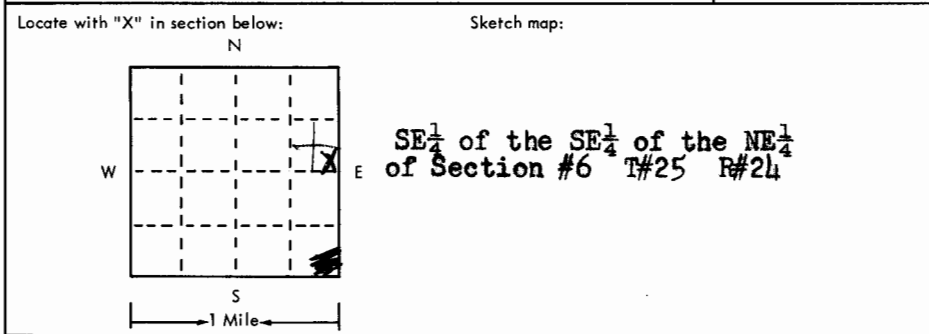

4 Well depth: **50** ft. Date of completion **5-21-75**
Well diameter **8** in.

5 Cable tool Rotary Driven Dug
 Hollow rod Jetted Bored Reverse rotary

6 Use: Domestic Public supply Industry
 Irrigation Air conditioning Commercial
 Test well

7 Casing: Material **RMP** Height: above **SSW**
Threaded Welded Surface **12** in.
Diam. **5** in. to **50** ft. depth Drive shoe? Yes No
5 in. to **50** ft. depth

| 2 | Type and color of material | From | To |
|---|----------------------------|-------------|----|
| | Top soil & clay | 0 | 15 |
| | Clay | 15 | 28 |
| | Coarse sand | 28 | 45 |
| | Gray shale | (45) | 60 |
| | BRock 45' | | |
| | 25 | | |
| | 20' sat thick | | |
| | Alluvium | | |

8 Screen:
Manufacturer **Sunflower**
Type **RMP** Dia. **5"**
Slot/gauze **1/8"** Length **20 ft.**
Set between **25** ft. and **45** ft.
Fittings:
Gravel pack Yes No Size range of material **1/4"**

9 Static water level:
25 ft. below land surface Date **5-21-75**

10 Pumping level below land surfaces:
25 ft. after **1 1/2** hrs. pumping **50** g.p.m.
____ ft. after ____ hrs. pumping ____ g.p.m.
Estimated maximum yield **65** g.p.m.

11 Water sample submitted:
 Yes No Date _____

12 Well head completion:
 Pitless adapter **12** inches above grade

13 Well grouted? Yes No
 Neat cement Bentonite _____
Depth: From **7** ft. to **15** ft.

14 Nearest source of possible contamination:
ft. **100** Direction **West** Type **Seed** lot
Well disinfected upon completion? Yes No

15 Pump: Not installed
Manufacturer's name **Flint & Walling**
Model number **ZBK7** HP **3/4** Volts **230**
Length of drop pipe **47** ft. capacity **19** g.m.p.
Type:
 Submersible Turbine
 Jet Reciprocating
 Centrifugal Other

16 Remarks: elevation

Topography:
 Hill
 Slope
 Upland
 Valley

TOPO

2426
45
2381

17 Water well contractor's certification:
This well was drilled under my jurisdiction and this report is true to the best of my knowledge and belief.
JOE'S WELL SERVICE **179**
Business name License No.
Address **Box 174 Cimarron, Ks.**
Signed **Larry Crick** Date **8-29-75**
Authorized representative

25
24 W
6
SE SE NE