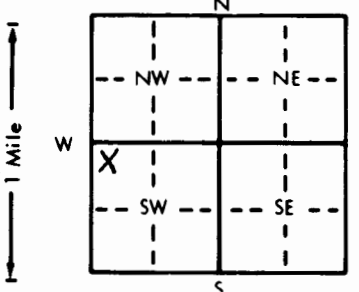


1 LOCATION OF WATER WELL: Fraction NW 1/4 NW 1/4 SW 1/4 Section Number 26 Township Number T 25 S Range Number R 24 EW

Distance and direction from nearest town or city street address of well if located within city?  
 From Junction 50 & 283 - 3miles North, 1 1/2 mile West and 1 1/2 miles North

2 WATER WELL OWNER: Lester Droste  
 RR#, St. Address, Box # : Board of Agriculture, Division of Water Resources  
 City, State, ZIP Code : Wright, Kansas 67882 Application Number:

3 LOCATE WELL'S LOCATION WITH AN "X" IN SECTION BOX:  
  
 4 DEPTH OF COMPLETED WELL... 295 ft. ELEVATION:  
 Depth(s) Groundwater Encountered 1. ft. 2. ft. 3. ft.  
 WELL'S STATIC WATER LEVEL... 169 ft. below land surface measured on mo/day/yr 12-20-88  
 Pump test data: Well water was ft. after hours pumping gpm  
 Est. Yield .25 gpm: Well water was ft. after hours pumping gpm  
 Bore Hole Diameter... 10 in. to 295 ft., and in. to ft.  
 WELL WATER TO BE USED AS:  
 5 Public water supply 8 Air conditioning 11 Injection well  
 1 Domestic 3 Feedlot 6 Oil field water supply 9 Dewatering 12 Other (Specify below)  
 2 Irrigation 4 Industrial 7 Lawn and garden only 10 Monitoring well  
 Was a chemical/bacteriological sample submitted to Department? Yes.....No..XX.....; If yes, mo/day/yr sample was submitted  
 Water Well Disinfected? Yes XX No

5 TYPE OF BLANK CASING USED:  
 1 Steel 3 RMP (SR) 5 Wrought iron 8 Concrete tile CASING JOINTS: Glued..XX..Clamped.....  
 2 PVC 4 ABS 6 Asbestos-Cement 9 Other (specify below) Welded.....  
 7 Fiberglass Threaded.....  
 Blank casing diameter... 5 in. to 295 ft., Dia in. to ft., Dia in. to ft.  
 Casing height above land surface... 12 in., weight SDR 21 lbs./ft. Wall thickness or gauge No. 200 psi  
 TYPE OF SCREEN OR PERFORATION MATERIAL:  
 1 Steel 3 Stainless steel 5 Fiberglass 7 PVC 8 RMP (SR) 10 Asbestos-cement 11 Other (specify).....  
 2 Brass 4 Galvanized steel 6 Concrete tile 9 ABS 12 None used (open hole)  
 SCREEN OR PERFORATION OPENINGS ARE:  
 1 Continuous slot 3 Mill slot 5 Gauzed wrapped 8 Saw cut 11 None (open hole)  
 2 Louvered shutter 4 Key punched 6 Wire wrapped 9 Drilled holes  
 7 Torch cut 10 Other (specify).....  
 SCREEN-PERFORATED INTERVALS: From... 260 ft. to 290 ft., From ft. to ft.  
 From ft. to ft., From ft. to ft.  
 GRAVEL PACK INTERVALS: From... 80 ft. to 295 ft., From ft. to ft.  
 From ft. to ft., From ft. to ft.

6 GROUT MATERIAL: 1 Neat cement 2 Cement grout 3 Bentonite 4 Other hole plug.....  
 Grout Intervals: From... 0 ft. to 80 ft., From ft. to ft., From ft. to ft.  
 What is the nearest source of possible contamination:  
 1 Septic tank 4 Lateral lines 7 Pit privy 10 Livestock pens 14 Abandoned water well  
 2 Sewer lines 5 Cess pool 8 Sewage lagoon 11 Fuel storage 15 Oil well/Gas well  
 3 Watertight sewer lines 6 Seepage pit 9 Feedyard 12 Fertilizer storage 16 Other (specify below)  
 13 Insecticide storage  
 Direction from well? Southeast How many feet? 60 ft.

FROM	TO	LITHOLOGIC LOG	FROM	TO	PLUGGING INTERVALS
0	15	Top soil & clay	315	330	Clay & red bed
15	30	Clay	330	345	Clay
30	60	Cleechie (lost circulation) large cracks			
60	70	Cleechie			
70	90	Blue shale			
90	135	Blue shale			
135	180	Gray clay & sand stone in layers			
180	195	Gray clay			
195	210	Gray clay & thin layers sand stone			
210	225	Gray clay & sand stone			
225	240	Gray clay & sand stone mostly sand stone			
240	255	Sand stone (5 ft.) & gray clay			
255	285	Gray clay & thin layers of sand stone			
285	300	Sand stone (very loose)			
300	315	Sand stone (2 ft.) & clay			

7 CONTRACTOR'S OR LANDOWNER'S CERTIFICATION: This water well was (1) constructed, (2) reconstructed, or (3) plugged under my jurisdiction and was completed on (mo/day/year) 1-17-89 and this record is true to the best of my knowledge and belief. Kansas Water Well Contractor's License No. 179 This Water Well Record was completed on (mo/day/yr) 2-17-89 under the business name of Joes WellService, Inc. Cimarron, Ks. by (signature) Judith Cisek