

USE TYPEWRITER OR BALL POINT PEN-PRESS FIRMLY, PRINT CLEARLY.


WATER WELL RECORD  
KSA 82a-1201-1215

Kansas Department of Health and Environment-Division of Environment (Water well Contractors) Topeka, Kansas 66620

BCC

1. Location of well: County Ford Fraction S W 1/4 SW 1/4 NW 1/4 Section number 31 Township number T 25 S Range number R 24 W E/W

2. Distance and direction from nearest town or city 4 miles north, 1/4 mile east, and 1/2 mile north of Dodge City, Kansas  
Street address of well location if in city:  
3. Owner of well: Randy T. Pegram  
R.R. or street: Rt. # 2  
City, state, zip code: Dodge City, Kansas 67801

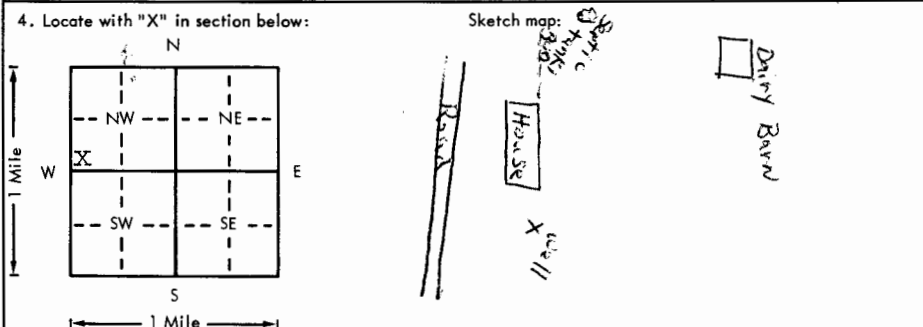

6. Bore hole dia. 9.75 in. Completion date 2-26-77  
Well depth 50 ft. 2-26-77  
7.  Cable tool  Rotary  Driven  Aug  
 Hollow rod  Jetted  Bored  Reverse rotary  
8. Use:  Domestic  Public supply  Industry  
 Irrigation  Air conditioning  Stock  
 Lawn  Oil field water  Other  
9. Casing: Material plts Height: Above or below  
Threaded  Welded  Surface 18 in.  
RMP  PVC  Weight 1.8 lbs./ft.  
Dia. 2 in. to 50 ft. depth Wall Thickness: inches or  
Dia.     in. to     ft. depth gage No. 0.250

5. Type and color of material	From	To
Surface	0	3
Brown caleche clay	3	18
Coarse sand and gravel	18	45
Yellow clay	45	50
Blue shale	50	60
<del>Rock 45</del>		
<del>20</del>		
<del>25 sat thick</del>		
<del>in Alluvium</del>		

10. Screen: Manufacturer's name Jess and Lowell  
Type RMP Dia. 5 in.  
Slot/gauze 1/16 in. Length 30 ft.  
Set between 20 ft. and 50 ft.  
    ft. and     ft.  
Gravel pack? yes Size range of material 1/4 - 1/8  
11. Static water level: 20 ft. below land surface Date 2-27-77 mo./day/yr.  
12. Pumping level below land surfaces:  
23 ft. after 1 hrs. pumping 30 g.p.m.  
    ft. after     hrs. pumping     g.p.m.  
Estimated maximum yield 30 g.p.m.  
13. Water sample submitted: Yes  No  Date      
14. Well head completion:  
 Pitless adapter 18 inches above grade  
15. Well grouted? yes  
With:  Neat cement  Bentonite  Concrete  
Depth: From 4 ft. to 28 ft.  
16. Nearest source of possible contamination:  
ft. 300 Direction North Type septic tank  
Well disinfected upon completion?  Yes  No  
17. Pump: Not installed  
Manufacturer's name REDA  
Model number 7D18P071 HP 3/4 Volts 220  
Length of drop pipe 38 ft. capacity 30 g.p.m.  
Type:  
 Submersible  Turbine  
 Jet  Reciprocating  
 Centrifugal  Other

18. Elevation: Topography: Hill  
 Hill  Slope  Upland  Valley  
19. Remarks: TOPO 2305  
45  
2460

20. Water well contractor's certification:  
This well was drilled under my jurisdiction and this report is true to the best of my knowledge and belief.  
Hodde Drilling Co. 302  
Business name RR# 1 Dodge City, KS License No.      
Address      
Signed Willie Hodde Jr. Date 3-10-77  
Authorized representative

25 240 31 SW SW NW Sec 1/4 1/4