


WATER WELL RECORD Form WWC-5 KSA 82a-1212

1 LOCATION OF WATER WELL: Fraction Section Number Township Number Range Number
 COUNTY: FORD SE 1/4 NE 1/4 SE 1/4 5 T 25 S R 24 *SW*

Distance and direction from nearest town or city street address of well if located within city?
 FROM GARNET & 14TH - 6 MILES NORTH ON 14TH, 3 MILES EAST

2 WATER WELL OWNER: ECCLBTON, VIOLA Board of Agriculture, Division of Water Resources
 RR#, St. Address, Box #: 10222 115TH ROAD Application Number:
 City, State, ZIP code: WRIGHT, KS 67882-

3 LOCATE WELL'S LOCATION WITH AN "X" IN SECTION BOX: 4 DEPTH OF COMPLETED WELL 285 ELEVATION: 0
 Depth(s) Groundwater Encountered 1. 0 ft. 2. 0 ft. 3. 0 ft.

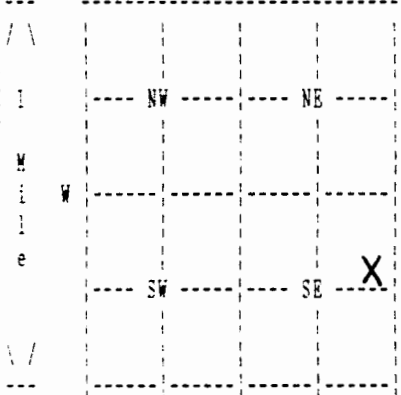

WELL'S STATIC WATER LEVEL 21 ft. below land surface measured on mo/day/yr 05/16/05
 Pump test data: Well water was 0 ft. after 0 hours pumping 0 gpm

Estimated Yield 30 gpm: Well water was 0 ft. after 0 hours pumping 0 gpm

Bore Hole Diameter 9 in. to 285 ft., and in. to 0 ft.

WELL WATER TO BE USED AS: DOMESTIC

Was a chemical/bacteriological sample submitted to department? No ;
 If yes, mo/day/yr sample was submitted Water well disinfected? Yes

5 TYPE OF BLANK CASING USED: PVC CASING JOINTS: GLUED
 Blank casing diameter 5 in. to 285 ft., Dia in. to 0 ft., Dia in. to 0 ft.
 Casing height above land surface 12 in., weight 200 lbs/ft. Wall thickness or gauge No. 21
 TYPE OF SCREEN OR PERFORATION MATERIAL: PVC
 SCREEN OR PERFORATION OPENINGS ARE: SAW CUT

SCREEN PERFORATED INTERVALS: From 30 ft. to 50 ft., From 0 ft. to 0 ft.
 From 240 ft. to 280 ft., From 0 ft. to 0 ft.
 GRAVEL PACK INTERVALS: From 23 ft. to 285 ft., From 0 ft. to 0 ft.
 From 0 ft. to 0 ft., From 0 ft. to 0 ft.

6 GROUT MATERIAL BENTONITE
 Grout Intervals: From 0 ft. to 23 ft., From 0 ft. to 0 ft., From 0 ft. to 0 ft.
 What is the nearest source of possible contamination: NONE
 Direction from well? How many feet? 0

FROM	TO	LITHOLOGIC LOG	FROM	TO	PLUGGING INTERVALS
0	20	01 TOPSOIL 05 CLAY			
20	30	05 CLAY			
30	50	37 FIN-COAR SAN 27 ROCK			
50	85	36 BLUE CLAY 31 SHALE			
85	100	29 SANDSTONE 16 GRAY CLAY			
100	200	16 GRAY CLAY			
200	220	16 GRAY CLAY 29 SANDSTONE 19 LAYERS			
220	280	29 SANDSTONE			
280	300	29 SANDSTONE 16 GRAY CLAY			
300	320	16 GRAY CLAY 26 RED CLAY			

CONTRACTOR'S OR LANDOWNER'S CERTIFICATION: This water well was Constructed under my jurisdiction and was completed on (mo/day/year) 05/30/05 and this record is true to the best of my knowledge and belief. Kansas Water Well Contractor's License No. 179 This Water Well Record was completed on (mo/day/yr) 05/31/05 under the business name of JOB'S WELL SERVICE, INC. by (signature) *Josiah Cook*