WATER WELL RECORD Form WWC-5 KSA 82a-1212

1 LOCATION OF WATER WELL:	Fraction	Section Number	Township Number	Range Number
COUNTY: FORD	SE 1/4 NE 1/4 SE 1/4	36	T 25 S	R 25 W

Distance and direction from nearest town or city street address of well if located within city?
FROM DODGE CITY - 3 NORTH ON AVE. A - 1/4 EAST AND 1/4 NORTH

2 WATER WELL OWNER: MARSHALL, MIKE
RR#, St. Address, Box # : 10571 112 ROAD
City, State, ZIP code : DODGE CITY, KS 67801-

Board of Agriculture, Division of Water Resources
Application Number:

3 LOCATE WELL'S LOCATION WITH AN "X" IN SECTION BOX:

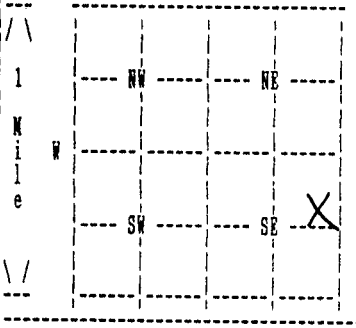

4 DEPTH OF COMPLETED WELL 75 ELEVATION: 0
Depth(s) Groundwater Encountered 1. 0 ft. 2. 0 ft. 3. 0 ft.

WELL'S STATIC WATER LEVEL 40 ft. below land surface measured on mo/day/yr 07/06/95
Pump testdata: Well water was 0 ft. after 0 hours pumping 0 gpm

Estimated Yield 30 gpm: Well water was 0 ft. after 0 hours pumping 0 gpm

Bore Hole Diameter 9 in. to 75 ft., and in. to 0 ft.

WELL WATER TO BE USED AS: DOMESTIC

Was a chemical/bacteriological sample submitted to department? No ;
If yes, mo/day/yr sample was submitted Water well disinfected? Yes

5 TYPE OF BLANK CASING USED: PVC CASING JOINTS: GLUED
Blank casing diameter 5 in. to 75 ft., Dia in. to 0 ft., Dia in. to 0 ft.
Casing height above land surface 12 in., weight 200 lbs/ft. Wall thickness or gauge No. 21
TYPE OF SCREEN OR PERFORATION MATERIAL: PVC
SCREEN OR PERFORATION OPENINGS ARE: SAW CUT

SCREEN PERFORATED INTERVALS:	From	50 ft. to	70 ft.,	From	0 ft. to	0 ft.
	From	0 ft. to	0 ft.,	From	0 ft. to	0 ft.
GRAVEL PACK INTERVALS:	From	25 ft. to	75 ft.,	From	0 ft. to	0 ft.
	From	0 ft. to	0 ft.,	From	0 ft. to	0 ft.

6 GROUT MATERIAL BENTONITE
Grout Intervals: From 5 ft. to 25 ft., From 0 ft. to 0 ft., From 0 ft. to 0 ft.
What is the nearest source of possible contamination: NONE - NEW SITE
Direction from well? How many feet? 0

FROM	TO	LITHOLOGIC LOG	FROM	TO	PLUGGING INTERVALS
0	10	TOPSOIL SANDY CLAY			
10	30	CALACHIE CLAY ROCK			
30	70	MEDIUM SAND GRAVEL			
70	90	SAND ROCK LAYER FINE SAND YELLOW CLAY			
90	100	BLUE SHALE			

7 CONTRACTOR'S OR LANDOWNER'S CERTIFICATION: This water well was Constructed under my jurisdiction and was completed on (mo/day/year) 08/03/95 and this record is true to the best of my knowledge and belief. Kansas Water Well Contractor's License No. 179 This Water Well Record was completed on (mo/day/yr) 08/10/95 under the business name of JOE'S WELL SERVICE, INC. by (signature) Jussid Crick