


1 LOCATION OF WATER WELL: County: **Ford** Fraction: **SW 1/4 SE 1/4 NE 1/4** Section Number: **22** Township Number: **T 25 S** Range Number: **R 25 E** **(W)**

Distance and direction from nearest town or city street address of well if located within city?  
**Approx. 5.8 Miles N & 1 Mile W of the Intersection of Alt 50, 14th St., Dodge City, KS**

2 WATER WELL OWNER: **Ford County** **01968001 MW-4S**  
 RR#, St. Address, Box #: **100 Gunsmoke** Board of Agriculture, Division of Water Resources  
 City, State, ZIP Code: **Dodge City, Kansas 67801** Application Number:

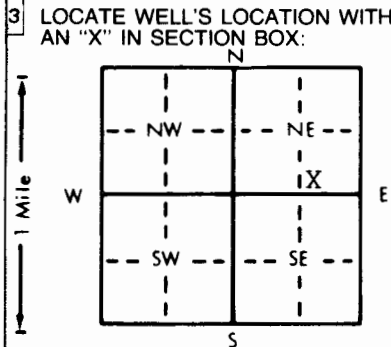

4 DEPTH OF COMPLETED WELL: **59** ft. ELEVATION: **2565**  
 Depth(s) Groundwater Encountered: **1. 50** ft. 2. ft. 3. ft.  
 WELL'S STATIC WATER LEVEL: **52.9** ft. below land surface measured on mo/day/yr: **01/10/96**  
 Pump test data: Well water was ft. after hours pumping gpm  
 Est. Yield: **N/A** gpm: Well water was ft. after hours pumping gpm  
 Bore Hole Diameter: **8.25** in. to **59** ft., and in. to ft.  
 WELL WATER TO BE USED AS:  
 5 Public water supply 8 Air conditioning 11 Injection well  
 1 Domestic 3 Feedlot 6 Oil field water supply 9 Dewatering 12 Other (Specify below)  
 2 Irrigation 4 Industrial 7 Lawn and garden only **10** Monitoring well  
 Was a chemical/bacteriological sample submitted to Department? Yes No **X**; If yes, mo/day/yr sample was submitted  
 Water Well Disinfected? Yes No **X**

5 TYPE OF BLANK CASING USED:  
 1 Steel 3 RMP (SR) 5 Wrought iron 8 Concrete tile CASING JOINTS: Glued Clamped  
**2** PVC 4 ABS 6 Asbestos-Cement 9 Other (specify below) Welded  
 7 Fiberglass Threaded **X**  
 Blank casing diameter: **2** in. to **44** ft., Dia. in. to ft., Dia. in. to ft.  
 Casing height above land surface: **36** in., weight lbs./ft. Wall thickness or gauge No. **Schedule 40**  
 TYPE OF SCREEN OR PERFORATION MATERIAL:  
 1 Steel 3 Stainless steel 5 Fiberglass 8 RMP (SR) 10 Asbestos-cement  
 2 Brass 4 Galvanized steel 6 Concrete tile 9 ABS 11 Other (specify)  
 12 None used (open hole)  
 SCREEN OR PERFORATION OPENINGS ARE:  
 1 Continuous slot **3** Mill slot 5 Gauzed wrapped 8 Saw cut 11 None (open hole)  
 2 Louvered shutter 4 Key punched 6 Wire wrapped 9 Drilled holes  
 7 Torch cut 10 Other (specify)  
 SCREEN-PERFORATED INTERVALS: From **44** ft. to **59** ft., From ft. to ft.  
 From ft. to ft., From ft. to ft.  
 GRAVEL PACK INTERVALS: From **41** ft. to **59** ft., From ft. to ft.  
 From ft. to ft., From ft. to ft.

6 GROUT MATERIAL: **1** Neat cement 2 Cement grout **3** Bentonite 4 Other  
 Grout Intervals: From **0** ft. to **39** ft., From **39** ft. to **41** ft., From ft. to ft.  
 What is the nearest source of possible contamination:  
 1 Septic tank 4 Lateral lines 7 Pit privy 10 Livestock pens 14 Abandoned water well  
 2 Sewer lines 5 Cess pool 8 Sewage lagoon 11 Fuel storage 15 Oil well/Gas well  
 3 Watertight sewer lines 6 Seepage pit 9 Feedyard 12 Fertilizer storage 16 Other (specify below)  
 13 Insecticide storage  
 Direction from well? How many feet?

FROM	TO	LITHOLOGIC LOG	FROM	TO	PLUGGING INTERVALS
0	0.5	Topsoil			
0.5	11.0	Lean Clay, Trace Sand, Brown			
11.0	14.0	Lean to Fat Clay, Trace Sand, Brown			
14.0	16.0	Sandy Lean Clay, Brown			
16.0	26.0	Lean Clay, Trace Sand, Brown			
26.0	36.0	Sandy Lean Clay, Brown			
36.0	48.0	Lean to Fat Clay, Trace Sand, Brown			
48.0	59.0	Sandy, Lean to Fat Clay, Brown			

7 CONTRACTOR'S OR LANDOWNER'S CERTIFICATION: This water well was **1** constructed, (2) reconstructed, or (3) plugged under my jurisdiction and was completed on (mo/day/year) **01/09/96** and this record is true to the best of my knowledge and belief. Kansas Water Well Contractor's License No. **416** This Water Well Record was completed on (mo/day/year) **02/02/96** under the business name of **Terracon Consultants, Inc.** by (signature) *Steve Fischer*