


1 LOCATION OF WATER WELL: Fraction SE 1/4 SE 1/4 SW 1/4 Section Number 12 Township Number T 25 S Range Number R 25 EW

County: Ford  
 Distance and direction from nearest town or city street address of well if located within city?  
From Dodge City, 7 miles north on 14th St. then 1 1/2 miles east.

2 WATER WELL OWNER: Elmer Rufer  
 RR#, St. Address, Box #: 1122 Chestnut Rd. Board of Agriculture, Division of Water Resources  
 City, State, ZIP Code: Dodge City, KS. 67801 Application Number:

3 LOCATE WELL'S LOCATION WITH AN "X" IN SECTION BOX:

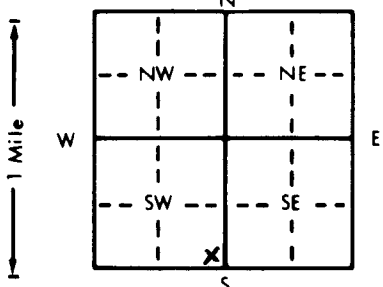

4 DEPTH OF COMPLETED WELL: 200' ft. ELEVATION:

Depth(s) Groundwater Encountered 1. .... ft. 2. .... ft. 3. .... ft.  
 WELL'S STATIC WATER LEVEL 133' ft. below land surface measured on mo/day/yr 12-31-96  
 Pump test data: Well water was .... ft. after .... hours pumping .... gpm  
 Est. Yield .... gpm: Well water was .... ft. after .... hours pumping .... gpm  
 Bore Hole Diameter: 9 7/8" in. to 100 ft., and .... in. to .... ft.  
 WELL WATER TO BE USED AS: 5 Public water supply 8 Air conditioning 11 Injection well  
 Domestic 3 Feedlot 6 Oil field water supply 9 Dewatering 12 Other (Specify below)  
 Irrigation 4 Industrial 7 Lawn and garden only 10 Monitoring well  
 Was a chemical/bacteriological sample submitted to Department? Yes.....No. ; If yes, mo/day/yr sample was submitted  
 Water Well Disinfected? Yes  No

5 TYPE OF BLANK CASING USED: 5 Wrought iron 8 Concrete tile CASING JOINTS: Glued  Clamped .....

1 Steel 3 RMP (SR) 6 Asbestos-Cement 9 Other (specify below) Welded .....

PVC 4 ABS 7 Fiberglass Threaded .....

Blank casing diameter 5" in. to 160' ft., Dia. .... in. to .... ft., Dia. .... in. to .... ft.  
 Casing height above land surface: 12" in., weight .... lbs./ft. Wall thickness or gauge No. SOR 21

TYPE OF SCREEN OR PERFORATION MATERIAL:  PVC 10 Asbestos-cement

1 Steel 3 Stainless steel 5 Fiberglass 8 RMP (SR) 11 Other (specify) .....

2 Brass 4 Galvanized steel 6 Concrete tile 9 ABS 12 None used (open hole)

SCREEN OR PERFORATION OPENINGS ARE: 5 Gauzed wrapped  Saw cut 11 None (open hole)

1 Continuous slot 3 Mill slot 6 Wire wrapped 9 Drilled holes

2 Louvered shutter 4 Key punched 7 Torch cut 10 Other (specify) .....

SCREEN-PERFORATED INTERVALS: From 160 ft. to 200 ft., From .... ft. to .... ft.  
 From .... ft. to .... ft., From .... ft. to .... ft.

GRAVEL PACK INTERVALS: From 24 ft. to 200 ft., From .... ft. to .... ft.  
 From .... ft. to .... ft., From .... ft. to .... ft.

6 GROUT MATERIAL: 1 Neat cement 2 Cement grout  Bentonite 4 Other .....

Grout Intervals: From 4 ft. to 24 ft., From .... ft. to .... ft., From .... ft. to .... ft.

What is the nearest source of possible contamination:  Livestock pens 14 Abandoned water well

1 Septic tank 4 Lateral lines 7 Pit privy 11 Fuel storage 15 Oil well/Gas well

2 Sewer lines 5 Cess pool 8 Sewage lagoon 12 Fertilizer storage 16 Other (specify below)

3 Watertight sewer lines 6 Seepage pit 9 Feedyard 13 Insecticide storage

Direction from well? Southeast How many feet? 30'

FROM	TO	LITHOLOGIC LOG	FROM	TO	PLUGGING INTERVALS
<u>0</u>	<u>2</u>	<u>Topsoil</u>			
<u>2</u>	<u>15</u>	<u>Brown clay + caliche</u>			
<u>15</u>	<u>16</u>	<u>Hard rock</u>			
<u>16</u>	<u>150</u>	<u>Shale + rock layers</u>			
<u>150</u>	<u>200</u>	<u>Shale + sandstone layers</u>			

7 CONTRACTOR'S OR LANDOWNER'S CERTIFICATION: This water well was  constructed, (2) reconstructed, or (3) plugged under my jurisdiction and was completed on (mo/day/year) 12-31-96 and this record is true to the best of my knowledge and belief. Kansas Water Well Contractor's License No. 533 This Water Well Record was completed on (mo/day/yr) 1-10-97 under the business name of Jantzen Water Well Repair by (signature) [Signature]