


1 LOCATION OF WATER WELL: Fraction NE 1/4 NE 1/4 NW 1/4 Section Number 1 Township Number T 25 S Range Number R 25 EW
 County: FORD

Distance and direction from nearest town or city street address of well if located within city?
APPROX. 10 MI NORTH OF DODGE CITY, KS.

2 WATER WELL OWNER: DONALD BIEDFELD Board of Agriculture, Division of Water Resources
 RR#, St. Address, Box #: RA.1 Application Number:
 City, State, ZIP Code: DODGE CITY, KS 67801

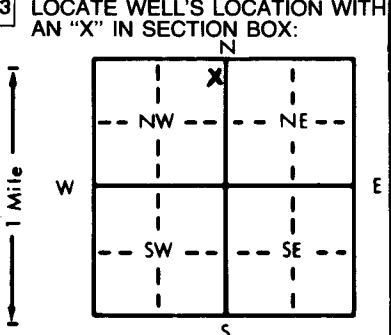

4 DEPTH OF COMPLETED WELL... 300 ft. ELEVATION:
 Depth(s) Groundwater Encountered 1... 28 ft. 2... 260 ft. 3... ft.
 WELL'S STATIC WATER LEVEL ... 92 ft. below land surface measured on mo/day/yr 5-1-86
 Pump test data: Well water was ft. after hours pumping gpm
 Est. Yield gpm: Well water was ft. after hours pumping gpm
 Bore Hole Diameter... 10 in. to 300 ft., and in. to ft.
 WELL WATER TO BE USED AS: 5 Public water supply 8 Air conditioning 11 Injection well
1 Domestic 3 Feedlot 6 Oil field water supply 9 Dewatering 12 Other (Specify below)
 2 Irrigation 4 Industrial 7 Lawn and garden only 10 Observation well
 Was a chemical/bacteriological sample submitted to Department? Yes.....No. ; If yes, mo/day/yr sample was submitted
 Water Well Disinfected? Yes No

5 TYPE OF BLANK CASING USED: 5 Wrought iron 8 Concrete tile CASING JOINTS: Glued Clamped
 1 Steel 3 RMP (SR) 6 Asbestos-Cement 9 Other (specify below) Welded
2 PVC 4 ABS 7 Fiberglass Threaded
 Blank casing diameter 5 in. to 300 ft., Dia in. to ft., Dia in. to ft.
 Casing height above land surface 18 in., weight 200 lbs./ft. Wall thickness or gauge No. JET STREAM 200
 TYPE OF SCREEN OR PERFORATION MATERIAL: 7 PVC 10 Asbestos-cement
 1 Steel 3 Stainless steel 5 Fiberglass 8 RMP (SR) 11 Other (specify)
 2 Brass 4 Galvanized steel 6 Concrete tile 9 ABS 12 None used (open hole)
 SCREEN OR PERFORATION OPENINGS ARE: 5 Gauzed wrapped 8 Saw cut 11 None (open hole)
 1 Continuous slot 3 Mill slot 6 Wire wrapped 9 Drilled holes
 2 Louvered shutter 4 Key punched 7 Torch cut 10 Other (specify)
 SCREEN-PERFORATED INTERVALS: From 240 ft. to 300 ft., From ft. to ft.
 From ft. to ft., From ft. to ft.
 GRAVEL PACK INTERVALS: From 100 ft. to 300 ft., From ft. to ft.
 From 10 ft. to 90 ft., From ft. to ft.

6 GROUT MATERIAL: 1 Neat cement 2 Cement grout 3 Bentonite 4 Other
 Grout Intervals: From 90 ft. to 100 ft., From 3 ft. to 10 ft., From ft. to ft.
 What is the nearest source of possible contamination:
1 Septic tank 4 Lateral lines 7 Pit privy 10 Livestock pens 14 Abandoned water well
 2 Sewer lines 5 Cess pool 8 Sewage lagoon 11 Fuel storage 15 Oil well/Gas well
 3 Watertight sewer lines 6 Seepage pit 9 Feedyard 12 Fertilizer storage 16 Other (specify below)
 13 Insecticide storage
 Direction from well? SOUTH How many feet? 250 ft.

FROM	TO	LITHOLOGIC LOG	FROM	TO	LITHOLOGIC LOG
0	6	DIRT			
6	28	CLAY			
28	35	LARGE GRAVEL			
35	260	BLUE SHALE			
260	300	DAKOTA SAND STONE			
300	-	BLUE SHALE			

7 CONTRACTOR'S OR LANDOWNER'S CERTIFICATION: This water well was 1 constructed, (2) reconstructed, or (3) plugged under my jurisdiction and was completed on (mo/day/year) 5-2-86 and this record is true to the best of my knowledge and belief. Kansas Water Well Contractor's License No. 423-A This Water Well Record was completed on (mo/day/yr) 5-2-86 under the business name of CLINE DRILLING CO. by (signature) Jack D. Cline
 INSTRUCTIONS: Use typewriter or ball point pen, PLEASE PRESS FIRMLY and PRINT clearly. Please fill in blanks, underline or circle the correct answers. Send top three copies to Kansas Department of Health and Environment, Division of Environment, Environmental Geology Section, Topeka, KS 66620. Send one to WATER WELL OWNER and retain one for your records.

04-8403738633