USE TYPEWRITER OR BALL POINT PEN-PRESS FIRMLY, PRINT CLEARLY.

DODGE CITY NE

WATER WELL RECORD
KSA 82a-1201-1215

BAC

T	R	EW	sec	1/4	1/4	1/4	No.

Kansas State Dept. Of Health
(Water Well Contractors)
Forbes-Bldg. 740
Topeka, Kansas 66620

1 Location of well:	County	Township name	Section	Section number	Town number	Range number
	Ford	Royal	~~NE¼ of NW¼~~ SE NE NW	4	T-25-S	R-25-W

Distance and direction from nearest town or city:
8 mi north & 1½ west of Dodge City
Street address of well location if in city:

3 Owner of well: Galen Durr
Address: Dodge City, Kansas

Locate with "X" in section below: Sketch map:

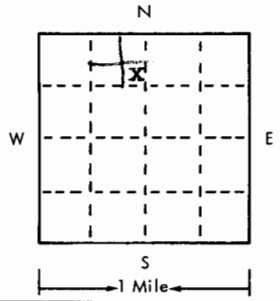

4 Well depth: ~~228~~ 26 ft. Date of completion 11-6-75
Well diameter 26 in.

5 ☐ Cable tool ☐ Rotary ☐ Driven ☐ Dug
☐ Hollow rod ☐ Jetted ☐ Bored ☒ Reverse rotary

6 Use: ☐ Domestic ☐ Public supply ☐ Industry
☒ Irrigation ☐ Air conditioning ☐ Commercial
☐ Test well ☐

7 Casing: Material Metal Height: above/below
Threaded ☐ Welded ☒ Surface 12 in.
Diam. 16 in. to 228 ft. depth Weight 30.30 lbs./ft. 1
Drive shoe? ☐ Yes ☒ No
___ in. to ___ ft. depth

8 Screen:
Manufacturer WA Brown
Type Free-flo Dia. 16
Slot/gauze 1/8 Length 2"
Set between ~~152~~ 224 ft. and ___ ft.
Fittings:
Gravel pack ☒ Yes ☐ No Size range of material ½ Dn

9 Static water level: 160 ft. below land surface Date ___

10 Pumping level below land surfaces:
220 ft. after 8 hrs. pumping 250 g.p.m.
___ ft. after ___ hrs. pumping ___ g.p.m.
Estimated maximum yield 250 g.p.m.

11 Water sample submitted:
☐ Yes ☒ No Date ___

12 Well head completion:
☐ Pitless adapter ☒ Inches above grade

13 Well grouted? ☒ Yes ☐ No
☒ Neat cement ☐ Bentonite ☐ ___
Depth: From 0 ft. to 10 ft.

14 Nearest source of possible contamination: NA
ft. ___ Direction ___ Type ___
Well disinfected upon completion? ☐ Yes ☒ No

15 Pump: ☒ Not installed
Manufacturer's name ___
Model number ___ HP ___ Volts ___
Length of drop pipe ___ ft. capacity ___ g.m.p.
Type:
☐ Submersible ☐ Turbine
☐ Jet ☐ Reciprocating
☐ Certrifugal ☐ Other

2 Type and color of material	From	To
Surface	0	3
Brown & yellow clay with rock layers	3	37
Gray and blue shale with rock layers	37	155
A-1 gray and brown sandstone	155	224
Gray shale	224	259
B Rock ~ 20'		
(use a second sheet if needed)		

16 Remarks: elevation

Topography:
☐ Hill
☐ Slope
☒ Upland
☐ Valley

2540
20
2520

17 Water well contractor's certification:
This well was drilled under my jurisdiction and this report is true to the best of my knowledge and belief.
Business name Ace-Hi International Inc License No. 190
Address Box 1442, Dodge City, Ks
Signed Carl G. Gittel Date 11-8-75
Authorized representative

25 25 W 4 SENE NW

Forward the white, blue and pink copies to the Kansas State Dept. Of Health.

Form WWC-5