


Over

WATER WELL RECORD Form WWC-5 KSA 82a-1212

1 LOCATION OF WATER WELL: COUNTY: FORD	Fraction NE 1/4 SE 1/4 NW 1/4	Section Number 5	Township Number T 25 S	Range Number R 25 W
---	----------------------------------	---------------------	---------------------------	------------------------

Distance and direction from nearest town or city street address of well if located within city?
FROM DODGE CITY, KS. 7 MILES NORTH, 2 MILES WEST & 1/2 EAST

2 WATER WELL OWNER: RR#, St. Address, Box # : City, State, ZIP code :	MARK MILLER BOX 396 R.R. #2 DODGE CITY, KS 67801-	Board of Agriculture, Division of Water Resources Application Number:
---	---	--

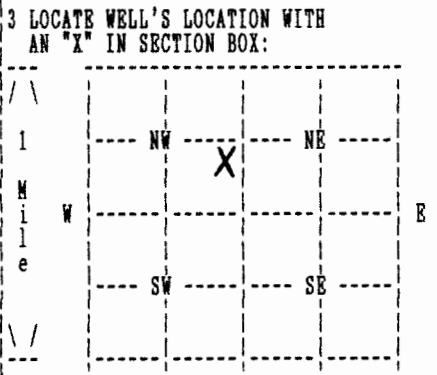

4 DEPTH OF COMPLETED WELL 270 ELEVATION: 0
 Depth(s) Groundwater Encountered 1. 0 ft. 2. 0 ft. 3. 0 ft.
 WELL'S STATIC WATER LEVEL 180 ft. below land surface measured on mo/day/yr 02/13/92
 Pump testdata: Well water was 0 ft. after 0 hours pumping 0 gpm
 Estimated Yield 30 gpm: Well water was 0 ft. after 0 hours pumping 0 gpm
 Bore Hole Diameter 8 in. to 270 ft., and in. to 0 ft.
 WELL WATER TO BE USED AS: DOMESTIC
 Was a chemical/bacteriological sample submitted to department? No ;
 If yes, mo/day/yr sample was submitted Water well disinfected? Yes

5 TYPE OF BLANK CASING USED: PVC CASING JOINTS: GLUED
 Blank casing diameter 5 in. to 270 ft., Dia in. to 0 ft., Dia in. to 0 ft.
 Casing height above land surface 12 in., weight 21 lbs/ft. Wall thickness or gauge No. 200
 TYPE OF SCREEN OR PERFORATION MATERIAL: PVC
 SCREEN OR PERFORATION OPENINGS ARE: SAW CUT

SCREEN PERFORATED INTERVALS:	From 200 ft. to 260 ft.,	From 0 ft. to 0 ft.
	From 0 ft. to 0 ft.,	From 0 ft. to 0 ft.
GRAVEL PACK INTERVALS:	From 35 ft. to 270 ft.,	From 0 ft. to 0 ft.
	From 0 ft. to 0 ft.,	From 0 ft. to 0 ft.

6 GROUT MATERIAL BENTONITE
 Grout Intervals: From 5 ft. to 35 ft., From 0 ft. to 0 ft., From 0 ft. to 0 ft.
 What is the nearest source of possible contamination: SEPTIC TANK
 Direction from well? EAST How many feet? 125

FROM	TO	LITHOLOGIC LOG	FROM	TO	PLUGGING INTERVALS
0	20	TOPSOIL CLAY LIMESTONE			
20	35	LIMESTONE CLAY LAYER(S)			
35	160	SHALE			
160	180	SHALE SANDSTONE LAYER(S)			
180	318	SANDSTONE			
318	320	ROCK LAYER(S)			
320	340	CLAY ROCK LAYER(S)			

7 CONTRACTOR'S OR LANDOWNER'S CERTIFICATION: This water well was Constructed under my jurisdiction and was completed on (mo/day/year) 02/14/92 and this record is true to the best of my knowledge and belief. Kansas Water Well Contractor's License No. 179 This Water Well Record was completed on (mo/day/yr) 03/17/92 under the business name of JOB'S WELL SERVICE, INC. by (signature) *James Cook*