


WATER WELL RECORD Form WWC-5 KSA 82a-1212

1 LOCATION OF WATER WELL: Fraction SE 1/4 SE 1/4 SE 1/4 Section Number 17 Township Number T 25 S Range Number R 25 E/W
 County: FORD

Distance and direction from nearest town or city street address of well if located within city?
6 North and 2 West of Dodge City, Kansas

2 WATER WELL OWNER: Mr. Marvin Hampton
 RR#, St. Address, Box #: Route #2 Board of Agriculture, Division of Water Resources
 City, State, ZIP Code: Dodge City, Kansas 67801 Application Number: ---

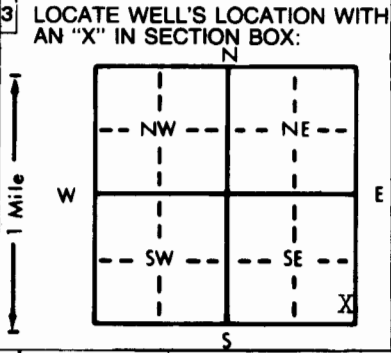

4 DEPTH OF COMPLETED WELL: 80 ft. ELEVATION: Upland
 Depth(s) Groundwater Encountered 1. Not available 2. Not available 3. Not available ft.
 WELL'S STATIC WATER LEVEL 58 ft. below land surface measured on mo/day/yr October 6, 1986
 Pump test data: Well water was Not available ft. after Not available hours pumping Not available gpm
 Est. Yield 10 gpm: Well water was Not available ft. after Not available hours pumping Not available gpm
 Bore Hole Diameter 9 7/8 in. to 80 ft., and Not available in. to Not available ft.
 WELL WATER TO BE USED AS:
 5 Public water supply 8 Air conditioning 11 Injection well
 3 Domestic 3 Feedlot 6 Oil field water supply 9 Dewatering 12 Other (Specify below)
 2 Irrigation 4 Industrial 7 Lawn and garden only 10 Observation well
 Was a chemical/bacteriological sample submitted to Department? Yes Not available No ; If yes, mo/day/yr sample was submitted Not available
 Water Well Disinfected? Yes No

5 TYPE OF BLANK CASING USED:
 1 Steel 3 RMP (SR) 5 Wrought iron 8 Concrete tile CASING JOINTS: Glued Clamped
 PVC 4 ABS 6 Asbestos-Cement 9 Other (specify below) Welded
 Fiberglass Threaded
 Blank casing diameter 5 in. to 60 ft., Dia. Not available in. to Not available ft., Dia. Not available in. to Not available ft.
 Casing height above land surface 12 in., weight 2.8 lbs./ft. Wall thickness or gauge No. 265

TYPE OF SCREEN OR PERFORATION MATERIAL:
 1 Steel 3 Stainless steel 5 Fiberglass 8 RMP (SR) 11 Other (specify)
 2 Brass 4 Galvanized steel 6 Concrete tile 9 ABS 12 None used (open hole)

SCREEN OR PERFORATION OPENINGS ARE:
 1 Continuous slot 3 Mill slot 5 Gauzed wrapped 8 Saw cut 11 None (open hole)
 2 Louvered shutter 4 Key punched 6 Wire wrapped 9 Drilled holes

SCREEN-PERFORATED INTERVALS: From 60 ft. to 80 ft., From Not available ft. to Not available ft.
 From Not available ft. to Not available ft., From Not available ft. to Not available ft.
GRAVEL PACK INTERVALS: From 10 ft. to 80 ft., From Not available ft. to Not available ft.
 From Not available ft. to Not available ft., From Not available ft. to Not available ft.

6 GROUT MATERIAL: 1 Neat cement 2 Cement grout 3 Bentonite 4 Other
 Grout intervals: From 0 ft. to 10 ft., From Not available ft. to Not available ft., From Not available ft. to Not available ft.
 What is the nearest source of possible contamination: NONE
 1 Septic tank 4 Lateral lines 7 Pit privy 10 Livestock pens 14 Abandoned water well
 2 Sewer lines 5 Cess pool 8 Sewage lagoon 11 Fuel storage 15 Oil well/Gas well
 3 Watertight sewer lines 6 Seepage pit 9 Feedyard 12 Fertilizer storage 16 Other (specify below)
 13 Insecticide storage

Direction from well? Not available How many feet? Not available

FROM	TO	LITHOLOGIC LOG	FROM	TO	LITHOLOGIC LOG
0	60	Clay			
60	80	Med. Sand			

7 CONTRACTOR'S OR LANDOWNER'S CERTIFICATION: This water well was (1) constructed, (2) reconstructed, or (3) plugged under my jurisdiction and was completed on (mo/day/year) October 6, 1986 and this record is true to the best of my knowledge and belief. Kansas Water Well Contractor's License No. 252 This Water Well Record was completed on (mo/day/year) October 22, 1986 under the business name of FRIESEN WINDMILL & SUPPLY INC. by (signature) [Signature]

INSTRUCTIONS: Use typewriter or ball point pen. PLEASE PRESS FIRMLY and PRINT clearly. Please fill in blanks, underline or circle the correct answers. Send top three copies to Kansas Department of Health and Environment, Office of Oil Field and Environmental Geology, Regulation and Permitting Section, Topeka, Kansas 66620-7500, Telephone: 913-862-9360. Send one to WATER WELL OWNER and retain one for your records.

Prepaid