

USE TYPEWRITER OR BALL POINT PEN-PRESS FIRMLY, PRINT CLEARLY.

WATER WELL RECORD
KSA 82a-1201-1215


Kansas Department of Health and Environment-Division of Environment
(Water well Contractors)
Topeka, Kansas 66620

DODGE CITY

C A B

1. Location of well: County **FORD** Fraction **NW 1/4 NE 1/4 SW 1/4** Section number **22** Township number **T 25 S** Range number **R 25 CW**

2. Distance and direction from nearest town or city: **8 mile N Dodge** 3. Owner of well: **Bob CRAIG**
Street address of well location if in city: R.R. or street: **North Star Rt**
City, state, zip code: **Dodge City ks 67801**

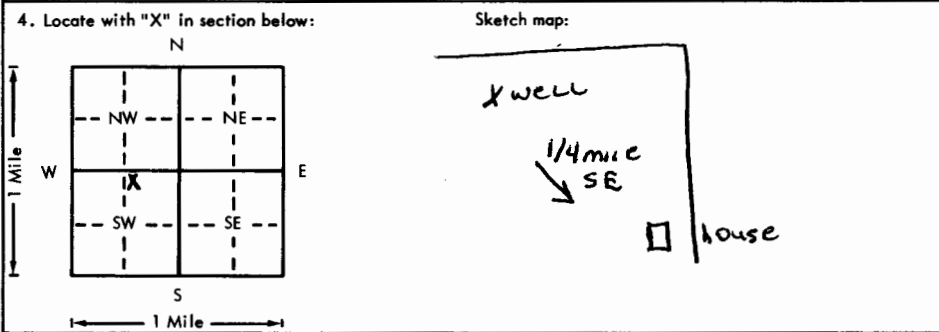

6. Bore hole dia. **8** in. Completion date **31 Jan 76**
Well depth **90** ft.

7. Cable tool Rotary Driven Dug
 Hollow rod Jetted Bored Reverse rotary

8. Use: Domestic Public supply Industry
 Irrigation Air conditioning Stock
 Lawn Oil field water Other

9. Casing: Material **PVC** Height: **Above** or below
Threaded Welded Surface **20** in.
RMP PVC **Clue** Weight **250** lbs./ft.
Dia. **5** in. to **90** ft. depth Wall Thickness: inches or
Dia. in. to ft. depth gage No. **1250**

5. Type and color of material	From	To
Topsoil 40 80	0	7
Clay (yellow)	7	37
Rock	37	41
Clay + Rock	41	64
Gravel Clay + Rock	64	89
Shale + Rock	89	90
ROCK 89'		
64		
25' sat thick		
11 of		

10. Screen: Manufacturer's name **Jess & Lowell**
Type **Pvc** Dia. **5**
Slot gauge **1/8** Length **3"**
Set between **60** ft. and **90** ft.
ft. and ft.
Gravel pack? Size range of material **1/8**

11. Static water level: mo./day/yr.
64 ft. below land surface Date **31 Jan 76**

12. Pumping level below land surfaces: **N/A**
 ft. after hrs. pumping g.p.m.
 ft. after hrs. pumping g.p.m.
Estimated maximum yield g.p.m.

13. Water sample submitted: mo./day/yr.
 Yes No Date

14. Well head completion:
 Pitless adapter **20** inches above grade

15. Well grouted?
With: Neat cement Bentonite Concrete
Depth: From **0** ft. to **13** ft.

16. Nearest source of possible contamination: **CORRAL**
ft. **1/4 MILE** Direction **SE** Type **CORRAL**
Well disinfected upon completion? Yes No

17. Pump: Not installed
Manufacturer's name _____
Model number _____ HP _____ Volts _____
Length of drop pipe _____ ft. capacity _____ g.p.m.
Type:
 Submersible Turbine
 Jet Reciprocating
 Centrifugal Other

18. Elevation: _____ 19. Remarks: _____

Topography:
 Hill
 Slope
 Upland
 Valley

20. Water well contractor's certification:
This well was drilled under my jurisdiction and this report is true to the best of my knowledge and belief.
CRAIG DRILLING **111**
Business name License No.
Address **Rt 1 Pch**
Signed **Ray Craig** Date **1 Feb 76**
Authorized representative

25 74
89
2485

25 25 E 22 NW 30 Sec 1/4 1/4 1/4