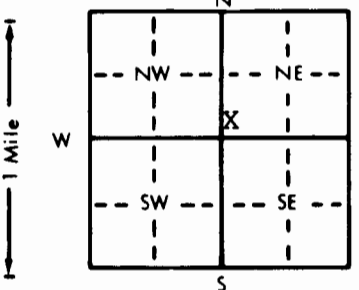


1 LOCATION OF WATER WELL: County: Ford	Fraction SW 1/4 SW 1/4 NE 1/4	Section Number 22	Township Number T 25 S	Range Number R 25 EW
--	---	-----------------------------	----------------------------------	--------------------------------

Distance and direction from nearest town or city street address of well if located within city?
6 Miles North of Dodge City, Kansas 01948009 MW-3

2 WATER WELL OWNER: **Ford County**
 RR#, St. Address, Box #: **c/o Ford County Clerk's Office** Board of Agriculture, Division of Water Resources
 City, State, ZIP Code: **100 Gunsmoke, Dodge City, Kansas 67801** Application Number:

3 LOCATE WELL'S LOCATION WITH AN "X" IN SECTION BOX:


4 DEPTH OF COMPLETED WELL: **98** ft. ELEVATION: **Approx. Surface Elev.: 2582** ft.
 Depth(s) Groundwater Encountered 1. **73** ft. 2. _____ ft. 3. _____ ft.
 WELL'S STATIC WATER LEVEL **68.3** ft. below land surface measured on mo/day/yr **04/29/94**
 Pump test data: Well water was _____ ft. after _____ hours pumping _____ gpm
 Est. Yield _____ gpm: Well water was _____ ft. after _____ hours pumping _____ gpm
 Bore Hole Diameter **9** in. to **105** ft., and _____ in. to _____ ft.
 WELL WATER TO BE USED AS:
 1 Domestic 3 Feedlot 6 Oil field water supply 9 Dewatering 12 Other (Specify below)
 2 Irrigation 4 Industrial 7 Lawn and garden only **10** Monitoring well
 Was a chemical/bacteriological sample submitted to Department? Yes _____ No **X**; If yes, mo/day/yr sample was submitted _____
 Water Well Disinfected? Yes _____ No **X**

5 TYPE OF BLANK CASING USED:
 1 Steel 3 RMP (SR) 5 Wrought iron 8 Concrete tile CASING JOINTS: Glued _____ Clamped _____
2 PVC 4 ABS 6 Asbestos-Cement 9 Other (specify below) Welded _____
 7 Fiberglass _____ Threaded **X**
 Blank casing diameter _____ in. to **53** ft., Dia _____ in. to _____ ft., Dia _____ in. to _____ ft.
 Casing height above land surface _____ in., weight _____ lbs./ft. Wall thickness or gauge No. **Schedule 40**
 TYPE OF SCREEN OR PERFORATION MATERIAL:
 1 Steel 3 Stainless steel 5 Fiberglass **7** PVC 10 Asbestos-cement
 2 Brass 4 Galvanized steel 6 Concrete tile 8 RMP (SR) 11 Other (specify) _____
 9 ABS 12 None used (open hole)
 SCREEN OR PERFORATION OPENINGS ARE:
 1 Continuous slot **3** Mill slot 5 Gauzed wrapped 8 Saw cut 11 None (open hole)
 2 Louvered shutter 4 Key punched 6 Wire wrapped 9 Drilled holes
 7 Torch cut 10 Other (specify) _____
 SCREEN-PERFORATED INTERVALS: From **53** ft. to **98** ft., From _____ ft. to _____ ft.
 From _____ ft. to _____ ft., From _____ ft. to _____ ft.
 GRAVEL PACK INTERVALS: From **50** ft. to **98** ft., From _____ ft. to _____ ft.
 From _____ ft. to _____ ft., From _____ ft. to _____ ft.

6 GROUT MATERIAL: **1** Neat cement 2 Cement grout **3** Bentonite 4 Other _____
 Grout Intervals: From **0.0** ft. to **48** ft., From **48** ft. to **50** ft., From _____ ft. to _____ ft.
 What is the nearest source of possible contamination:
 1 Septic tank 4 Lateral lines 7 Pit privy 10 Livestock pens 14 Abandoned water well
 2 Sewer lines 5 Cess pool 8 Sewage lagoon 11 Fuel storage 15 Oil well/Gas well
 3 Watertight sewer lines 6 Seepage pit 9 Feedyard 12 Fertilizer storage 16 Other (specify below)
 13 Insecticide storage _____
 Direction from well? _____ How many feet? _____

FROM	TO	LITHOLOGIC LOG	FROM	TO	PLUGGING INTERVALS
0.0	1.0	Topsoil	99.0	105.0	Shale; Dark Gray to Black
1.0	8.5	Silty Lean Clay, With Trace Fine Sand; Brown			
8.5	13.5	Silty, Lean to Fat Clay; Brown			
13.5	24.5	Silty, Lean to Fat Clay, With Calcareous; Brown			
24.5	43.5	Silty Lean Clay; Tan, With Calcareous Streaks			
43.5	58.5	Silty Lean Clay; Tan; With Trace Sand & Calcareous Nodules			
58.5	63.5	Silty Lean Clay, With Loose Sand and Cemented Sand			
63.5	88.5	Silty Sand, With Fine to Coarse Sand; Tan			
88.5	99.0	Silty Sand With Trace Gravel; Tan			

7 CONTRACTOR'S OR LANDOWNER'S CERTIFICATION: This water well was **1** constructed, (2) reconstructed, or (3) plugged under my jurisdiction and was completed on (mo/day/year) **04/28/94** and this record is true to the best of my knowledge and belief. Kansas Water Well Contractor's License No. **416** This Water Well Record was completed on (mo/day/yr) **4-22-94** under the business name of **Terracon Consultants, Inc.** by (signature) *Steven R. Fischer*

INSTRUCTIONS: Use typewriter or ball point pen. PLEASE PRESS FIRMLY and PRINT clearly. Please fill in blanks, underline or circle the correct answers. Send top three copies to Kansas Department of Health and Environment, Bureau of Water, Topeka, Kansas 66620-0001. Telephone: 913-296-5545. Send one to WATER WELL OWNER and retain one for your records.