


1 LOCATION OF WATER WELL: County: Ford Fraction: NE 1/4 NE 1/4 NW 1/4 Section Number: 32 Township Number: T 25 S Range Number: R 25 E/W

Distance and direction from nearest town or city street address of well if located within city? 5 miles North, 1/2 mile East 5 miles West of Dodge City, Ks. and

2 WATER WELL OWNER: Roy Orebaugh RR#, St. Address, Box #: Route #2 City, State, ZIP Code: Dodge City, Kansas 67801 Board of Agriculture, Division of Water Resources Application Number:

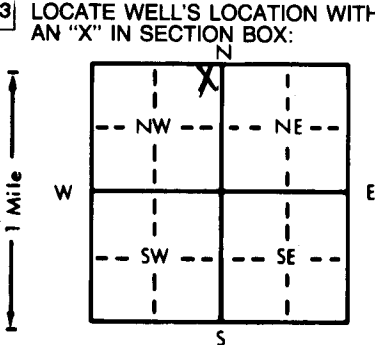

3 LOCATE WELL'S LOCATION WITH AN 'X' IN SECTION BOX: 4 DEPTH OF COMPLETED WELL: 95 ft. ELEVATION: ... WELL'S STATIC WATER LEVEL: 68 ft. below land surface measured on mo/day/yr Nov. 25, 1981. Pump test data: Well water was ... Est. Yield: 25 gpm. Bore Hole Diameter: 8 in. to 95 ft., and ... WELL WATER TO BE USED AS: 1 Domestic, 3 Feedlot, 6 Oil field water supply, 9 Dewatering, 12 Other (Specify below) stock well. Was a chemical/bacteriological sample submitted to Department? Yes... No... XX; If yes, mo/day/yr sample was submitted. Water Well Disinfected? Yes XXX No

5 TYPE OF BLANK CASING USED: 1 Steel, 2 PVC, 3 RMP (SR), 4 ABS, 5 Wrought iron, 6 Asbestos-Cement, 7 Fiberglass, 8 Concrete tile, 9 Other (specify below), 10 Observation well, 11 Injection well, 12 Other (Specify below) stock well. Blank casing diameter: 5 in. to 95 ft., Dia. Casing height above land surface: 12 in., weight: 200 psi. TYPE OF SCREEN OR PERFORATION MATERIAL: 1 Steel, 2 Brass, 3 Stainless steel, 4 Galvanized steel, 5 Fiberglass, 6 Concrete tile, 7 PVC, 8 RMP (SR), 9 ABS, 10 Asbestos-cement, 11 Other (specify), 12 None used (open hole). SCREEN OR PERFORATION OPENINGS ARE: 1 Continuous slot, 2 Louvered shutter, 3 Mill slot, 4 Key punched, 5 Gauzed wrapped, 6 Wire wrapped, 7 Torch cut, 8 Saw cut, 9 Drilled holes, 10 Other (specify), 11 None (open hole). SCREEN-PERFORATED INTERVALS: From 70 ft. to 90 ft. GRAVEL PACK INTERVALS: From 10 ft. to 95 ft.

6 GROUT MATERIAL: 1 Neat cement, 2 Cement grout, 3 Bentonite, 4 Other. Grout Intervals: From 50 ft. to 10 ft. What is the nearest source of possible contamination: none. 1 Septic tank, 2 Sewer lines, 3 Watertight sewer lines, 4 Lateral lines, 5 Cess pool, 6 Seepage pit, 7 Pit privy, 8 Sewage lagoon, 9 Feedyard, 10 Livestock pens, 11 Fuel storage, 12 Fertilizer storage, 13 Insecticide storage, 14 Abandoned water well, 15 Oil well/Gas well, 16 Other (specify below). Direction from well? How many feet?

FROM	TO	LITHOLOGIC LOG	FROM	TO	LITHOLOGIC LOG
0	15	Black topsoil & brown clay			
15	30	Brown clay			
30	45	Brown clay & white cleechy			
45	60	White cleechy layers & brown sandrock			
60	90	Medium sand & brown sandrock layers			
90	105	Shale			

7 CONTRACTOR'S OR LANDOWNER'S CERTIFICATION: This water well was (1) constructed, (2) reconstructed, or (3) plugged under my jurisdiction and was completed on (mo/day/year) Nov. 26, 1981 and this record is true to the best of my knowledge and belief. Kansas Water Well Contractor's License No. 179 This Water Well Record was completed on (mo/day/yr) June 22, 1982 under the business name of Joe's Well Service, Inc. Cimarron, Ks., by (signature) Larry Crick

INSTRUCTIONS: Use typewriter or ball point pen, PLEASE PRESS FIRMLY and PRINT clearly. Please fill in blanks, underline or circle the correct answers. Send top three copies to Kansas Department of Health and Environment, Division of Environment, Environmental Geology Section, Topeka, KS 66620. Send one to WATER WELL OWNER and retain one for your records.