


WATER WELL RECORD Form WWC-5 KSA 82a-1212

1 LOCATION OF WATER WELL: County: FORD Fraction: NE 1/4 NE 1/4 SW 1/4 Section Number: 36 Township Number: T 25 S Range Number: R 25 EW

2 WATER WELL OWNER: RAYFORD HILL RR# 2 AR # 2 DODGE CITY, KS, 67801 Board of Agriculture, Division of Water Resources Application Number:

3 LOCATE WELL'S LOCATION WITH AN 'X' IN SECTION BOX:

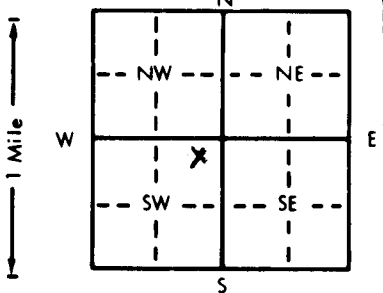

4 DEPTH OF COMPLETED WELL: 67 ft. ELEVATION: Depth(s) Groundwater Encountered: 1. 44 ft. 2. ... ft. 3. ... ft. WELL'S STATIC WATER LEVEL: 42 ft. below land surface measured on mo/day/yr 2-4-86 Pump test data: Well water was ... ft. after ... hours pumping ... gpm Est. Yield ... gpm: Well water was ... ft. after ... hours pumping ... gpm Bore Hole Diameter: 10 in. to 6.7 ft., and ... in. to ... ft. WELL WATER TO BE USED AS: 5 Public water supply 8 Air conditioning 11 Injection well 9 Domestic 3 Feedlot 6 Oil field water supply 9 Dewatering 12 Other (Specify below) 2 Irrigation 4 Industrial 7 Lawn and garden only 10 Observation well Was a chemical/bacteriological sample submitted to Department? Yes... No. X; If yes, mo/day/yr sample was sub-mitted Water Well Disinfected? Yes No

5 TYPE OF BLANK CASING USED: 1 Steel 2 PVC 3 RMP (SR) 4 ABS 5 Wrought iron 6 Asbestos-Cement 7 Fiberglass 8 Concrete tile 9 Other (specify below) CASING JOINTS: Glued X Clamped Welded Threaded Blank casing diameter: 5 in. to 4.7 ft., Dia. ... in. to ... ft., Dia. ... in. to ... ft. Casing height above land surface: 18 in., weight ... lbs./ft. Wall thickness or gauge No. JET-STRIP 200

TYPE OF SCREEN OR PERFORATION MATERIAL: 1 Steel 2 Brass 3 Stainless steel 4 Galvanized steel 5 Fiberglass 6 Concrete tile 7 PVC 8 RMP (SR) 9 ABS 10 Asbestos-cement 11 Other (specify) 12 None used (open hole) SCREEN OR PERFORATION OPENINGS ARE: 1 Continuous slot 2 Louvered shutter 3 Mill slot 4 Key punched 5 Gauzed wrapped 6 Wire wrapped 7 Torch cut 8 Saw cut 9 Drilled holes 11 None (open hole) 12 Other (specify)

SCREEN-PERFORATED INTERVALS: From 4.7 ft. to 6.7 ft. From ... ft. to ... ft. From ... ft. to ... ft. GRAVEL PACK INTERVALS: From 4.0 ft. to 6.7 ft. From ... ft. to ... ft. From ... ft. to ... ft.

6 GROUT MATERIAL: 1 Neat cement 2 Cement grout 3 Bentonite 4 Other Grout Intervals: From 3.2 ft. to 4.0 ft. From 0 ft. to 1.0 ft. From ... ft. to ... ft.

What is the nearest source of possible contamination: 1 Septic tank 2 Sewer lines 3 Watertight sewer lines 4 Lateral lines 5 Cess pool 6 Seepage pit 7 Pit privy 8 Sewage lagoon 9 Feedyard 10 Livestock pens 11 Fuel storage 12 Fertilizer storage 13 Insecticide storage 14 Abandoned water well 15 Oil well/Gas well 16 Other (specify below)

Direction from well? WEST How many feet? 680 FT.

Table with columns: FROM, TO, LITHOLOGIC LOG, FROM, TO, LITHOLOGIC LOG. Rows contain depth intervals and lithology: 0-8 DIRT, 8-22 CLAY, 22-23 FLINT ROCK, 23-37 LIMESTONE ROCK, 37-44 SOFT LIMESTONE-CLAY 15% , 44-67 LARGE SAND - GRAVEL BLUE SHALE

7 CONTRACTOR'S OR LANDOWNER'S CERTIFICATION: This water well was (1) constructed (2) reconstructed, or (3) plugged under my jurisdiction and was completed on (mo/day/year) 2-4-86 and this record is true to the best of my knowledge and belief. Kansas Water Well Contractor's License No. 423 A This Water Well Record was completed on (mo/day/yr) 2-4-86 under the business name of CLINE DRILLING CO. by (signature) Jack D. Cline

INSTRUCTIONS: Use typewriter or ball point pen, PLEASE PRESS FIRMLY and PRINT clearly. Please fill in blanks, underline or circle the correct answers. Send top three copies to Kansas Department of Health and Environment, Division of Environment, Environmental Geology Section, Topeka, KS 66620. Send one to WATER WELL OWNER and retain one for your records.


OFFICE USE ONLY