


1 LOCATION OF WATER WELL: County: Ford	Fraction NE 1/4 NE 1/4 SW 1/4	Section Number 36	Township Number T 25 S	Range Number R 25 EW
--	---	-----------------------------	----------------------------------	---

Distance and direction from nearest town or city street address of well if located within city?
3 1/4 miles North on Avenue A - Dodge City, Kansas 67801

2 WATER WELL OWNER: **Rayford Hill Well #1**
 RR#, St. Address, Box # : **Route #2**
 City, State, ZIP Code : **Dodge City, Kansas 67801**
 Board of Agriculture, Division of Water Resources
 Application Number:

3 LOCATE WELL'S LOCATION WITH AN "X" IN SECTION BOX:

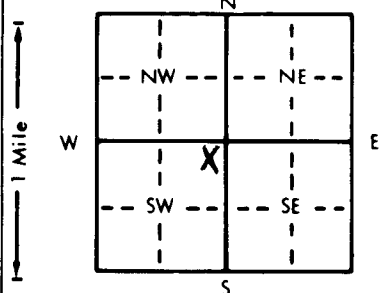

4 DEPTH OF COMPLETED WELL: **65** ft. ELEVATION:
 Depth(s) Groundwater Encountered 1. ft. 2. ft. 3. ft.
 WELL'S STATIC WATER LEVEL: **34** ft. below land surface measured on mo/day/yr **3-28-90**
 Pump test data: Well water was ft. after hours pumping gpm
 Est. Yield: **35** gpm: Well water was ft. after hours pumping gpm
 Bore Hole Diameter: **10** in. to **65** ft., and in. to ft.
 WELL WATER TO BE USED AS:
 1 Domestic 3 Feedlot 6 Oil field water supply 9 Dewatering 12 Other (Specify below)
 2 Irrigation 4 Industrial 7 Lawn and garden only 10 Monitoring well
 Was a chemical/bacteriological sample submitted to Department? Yes.....No...**XX**...; If yes, mo/day/yr sample was submitted
 Water Well Disinfected? Yes **XX** No

5 TYPE OF BLANK CASING USED:
 1 Steel 3 RMP (SR) 5 Wrought iron 8 Concrete tile CASING JOINTS: Glued...**XX**...Clamped...
 2 **PVC** 4 ABS 6 Asbestos-Cement 9 Other (specify below) Welded...
 7 Fiberglass Threaded...
 Blank casing diameter: **5** in. to **65** ft., Dia in. to ft., Dia in. to ft.
 Casing height above land surface: **12** in., weight **SDR 21** lbs./ft. Wall thickness or gauge No. **200 psi**

TYPE OF SCREEN OR PERFORATION MATERIAL:
 1 Steel 3 Stainless steel 5 Fiberglass 7 **PVC** 10 Asbestos-cement
 2 Brass 4 Galvanized steel 6 Concrete tile 8 RMP (SR) 11 Other (specify)
 12 None used (open hole)
 SCREEN OR PERFORATION OPENINGS ARE:
 1 Continuous slot 3 Mill slot 5 Gauzed wrapped 8 **Saw cut** 11 None (open hole)
 2 Louvered shutter 4 Key punched 6 Wire wrapped 9 Drilled holes
 7 Torch cut 10 Other (specify)

SCREEN-PERFORATED INTERVALS: From **38** ft. to **58** ft., From ft. to ft.
 GRAVEL PACK INTERVALS: From **25** ft. to **65** ft., From ft. to ft.

6 GROUT MATERIAL: 1 Neat cement 2 Cement grout 3 **Bentonite** 4 Other ..hole plug.....
 Grout Intervals: From **5** ft. to **25** ft., From ft. to ft., From ft. to ft.

What is the nearest source of possible contamination: **none - new bldg. site** 10 Livestock pens 14 Abandoned water well
 1 Septic tank 4 Lateral lines 7 Pit privy 11 Fuel storage 15 Oil well/Gas well
 2 Sewer lines 5 Cess pool 8 Sewage lagoon 12 Fertilizer storage 16 Other (specify below)
 3 Watertight sewer lines 6 Seepage pit 9 Feedyard 13 Insecticide storage

Direction from well? How many feet?

FROM	TO	LITHOLOGIC LOG	FROM	TO	PLUGGING INTERVALS
0	20	Top soil, clay and claichie			
20	40	Claichie, rock layer and medium to coarse sand			
40	55	Medium to coarse sand			
55	60	Clay & blue shale			

7 CONTRACTOR'S OR LANDOWNER'S CERTIFICATION: This water well was (1) constructed, (2) reconstructed, or (3) plugged under my jurisdiction and was completed on (mo/day/year) **3-28-90** and this record is true to the best of my knowledge and belief. Kansas Water Well Contractor's License No. **179** This Water Well Record was completed on (mo/day/yr) **6-1-90** under the business name of **Joe's Well Service, Inc. Cimarron, Ks.** by (signature) *Joseph Creek*