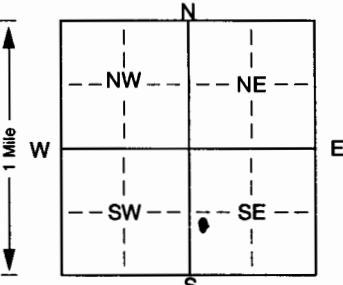


1] LOCATION OF WATER WELL: **NE** Section Number **34** Township Number **T 25 S** Range Number **R 25 EW**
 County: **Ford**

Distance and direction from nearest town or city street address of well if located within city?
3 N + 8 1/2 W from Dodge City

2] WATER WELL OWNER: **Larry Gillen**
 RR#, St. Address, Box # :
 City, State, ZIP Code : **Dodge City, KS 67801**
 Board of Agriculture, Division of Water Resources
 Application Number:

3] LOCATE WELL'S LOCATION WITH AN "X" IN SECTION BOX:

 4] DEPTH OF COMPLETED WELL... **100** ... ft. ELEVATION:
 Depth(s) Groundwater Encountered 1. ... ft. 2. ... ft. 3. ... ft.
 WELL'S STATIC WATER LEVEL... **82** ... ft. below land surface measured on mo/day/yr **4-3-02**
 Pump test data: Well water was **82** ft. after **1** hours pumping **30** gpm
 Est. Yield **50** gpm; Well water was ... ft. after ... hours pumping ... gpm
 Bore Hole Diameter... **8 1/4** in. to **100** ft., and ... in. to ... ft.
 WELL WATER TO BE USED AS: 5 Public water supply 8 Air conditioning 11 Injection well
 Domestic 3 Feedlot 6 Oil field water supply 9 Dewatering 12 Other (Specify below)
 2 Irrigation 4 Industrial 7 Domestic (lawn & garden) 10 Monitoring well ...
 Was a chemical/bacteriological sample submitted to Department? Yes. ... No. ; If yes, mo/day/yr sample was submitted
 Water Well Disinfected? Yes No

5] TYPE OF BLANK CASING USED:
 PVC 3 RMP (SR) 6 Asbestos-Cement 9 Other (specify below) Welded ...
 Steel 4 ABS 7 Fiberglass ... Threaded ...
 Blank casing diameter ... **5** in. to **80** ft., Dia ... in. to ... ft., Dia ... in. to ... ft.
 Casing height above land surface... **2.4** in., weight ... lbs./ft. Wall thickness or gauge No. **200**
 TYPE OF SCREEN OR PERFORATION MATERIAL:
 PVC 10 Asbestos-cement
 Steel 3 Stainless steel 5 Fiberglass 8 RMP (SR) 11 Other (specify) ...
 Brass 4 Galvanized steel 6 Concrete tile 9 ABS 12 None used (open hole)
 SCREEN OR PERFORATION OPENINGS ARE:
 Saw cut 11 None (open hole)
 Continuous slot 3 Mill slot 6 Wire wrapped 9 Drilled holes
 Louvered shutter 4 Key punched 7 Torch cut 10 Other (specify) ... ft.
 SCREEN-PERFORATED INTERVALS: From... **80** ft. to **100** ft., From ... ft. to ... ft.
 GRAVEL PACK INTERVALS: From... **20** ft. to **100** ft., From ... ft. to ... ft.

6] GROUT MATERIAL: 1 Neat cement 2 Cement grout Bentonite 4 Other ...
 Grout Intervals: From... **top** ft. to **20** ft., From ... ft. to ... ft., From ... ft. to ... ft.
 What is the nearest source of possible contamination:
 Septic tank 4 Lateral lines 7 Pit privy 10 Livestock pens 14 Abandoned water well
 Sewer lines 5 Cess pool 8 Sewage lagoon 11 Fuel storage 15 Oil well/Gas well
 Watertight sewer lines 6 Seepage pit 9 Feedyard 12 Fertilizer storage 16 Other (specify below)
 Direction from well? **SW** 13 Insecticide storage ... **irrigation well**
 How many feet? **200**

FROM	TO	LITHOLOGIC LOG	FROM	TO	PLUGGING INTERVALS
0	5	top soil			
5	70	brown clay			
70	100	sand & gravel			

7] CONTRACTOR'S OR LANDOWNER'S CERTIFICATION: This water well was constructed, (2) reconstructed, or (3) plugged under my jurisdiction and was completed on (mo/day/year) **4-4-02** and this record is true to the best of my knowledge and belief. Kansas Water Well Contractor's Licence No. **101**. This Water Well Record was completed on (mo/day/yr) **4-4-02** under the business name of **Barker Well Drilling Inc.** by (signature) **Reuben J. Bartzel**