

CORRECTION(S) TO WATER WELL RECORD (WWC-5)

(to rectify lacking or incorrect information)

County: Ford

Location listed as:

Location changed to:

Section-Township-Range: 4-25S-25E

4-25S-25W

Fraction ($\frac{1}{4}$ $\frac{1}{4}$ $\frac{1}{4}$): SE SE SW

SE SE SW

Other changes: Initial statements: _____

Changed to: _____

Comments: _____

verification method: Written & legal descriptions, position on plat map, and Ford County ownership map.

initials: DRJ date: 11/8/2004

submitted by: Kansas Geological Survey, Data Resources Library, 1930 Constant Ave., Lawrence, KS 66047-3726
to: Kansas Dept of Health & Environment, Bureau of Water, 1000 SW Jackson, Suite 420, Topeka, KS 66612-1367.


WATER WELL RECORD Form WWC-5 KSA 82a-1212

1 LOCATION OF WATER WELL: Fraction Section Number Township Number Range Number
 COUNTY: FORD SE 1/4 SE 1/4 SW 1/4 4 T 25 S R 25 E

Distance and direction from nearest town or city street address of well if located within city?
 FROM JUNCTION 283 NORTH & 50 EAST - 8 NORTH & 3 1/2 WEST

2 WATER WELL OWNER: REBBIN, BILL Board of Agriculture, Division of Water Resources
 RR#, St. Address, Box #: 1913 BURR PARKWAY Application Number:
 City, State, ZIP code: DODGE CITY, KS 67801-

3 LOCATE WELL'S LOCATION WITH AN "X" IN SECTION BOX: 4 DEPTH OF COMPLETED WELL 244 ELEVATION: 0
 Depth(s) Groundwater Encountered 1. 0 ft. 2. 0 ft. 3. 0 ft.

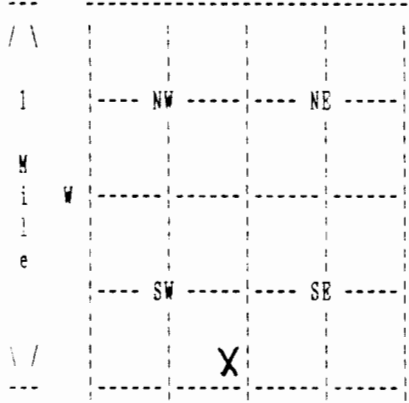

WELL'S STATIC WATER LEVEL 122 ft. below land surface measured on mo/day/yr 10/20/04
 Pump test data: Well water was 0 ft. after 0 hours pumping 0 gpm
 Estimated Yield 40 gpm: Well water was 0 ft. after 0 hours pumping 0 gpm
 Bore Hole Diameter 9 in. to 244 ft., and in. to 0 ft.
 WELL WATER TO BE USED AS: DOMESTIC
 Was a chemical/bacteriological sample submitted to department? No ;
 If yes, mo/day/yr sample was submitted Water well disinfected? Yes

5 TYPE OF BLANK CASING USED: PVC CASING JOINTS: GLUED
 Blank casing diameter 5 in. to 244 ft., Dia in. to 0 ft., Dia in. to 0 ft.
 Casing height above land surface 12 in., weight 200 lbs/ft. Wall thickness or gauge No. 21
 TYPE OF SCREEN OR PERFORATION MATERIAL: PVC
 SCREEN OR PERFORATION OPENINGS ARE: SAW CUT

SCREEN PERFORATED INTERVALS: From 200 ft. to 240 ft., From 0 ft. to 0 ft.
 From 0 ft. to 0 ft., From 0 ft. to 0 ft.
 GRAVEL PACK INTERVALS: From 25 ft. to 244 ft., From 0 ft. to 0 ft.
 From 0 ft. to 0 ft., From 0 ft. to 0 ft.

6 GROUT MATERIAL BENTONITE
 Grout Intervals: From 5 ft. to 25 ft., From 0 ft. to 0 ft., From 0 ft. to 0 ft.
 What is the nearest source of possible contamination: NONE
 Direction from well? How many feet? 0

FROM	TO	LITHOLOGIC LOG	FROM	TO	PLUGGING INTERVALS
0	20	01 TOPSOIL 05 CLAY 02 FINE SAND			
20	40	05 CLAY 37 FIN-COAR SAN			
40	60	32 TAN CLAY 36 BLUE CLAY			
60	80	36 BLUE CLAY 29 SANDSTONE			
80	100	29 SANDSTONE 16 GRAY CLAY			
100	160	16 GRAY CLAY 26 RED CLAY 29 SANDSTONE			
160	180	16 GRAY CLAY 08 ROCK LAYERS			
180	200	16 GRAY CLAY 29 SANDSTONE			
200	238	29 SANDSTONE			
238	260	16 GRAY CLAY 26 RED CLAY			

RECEIVED
 OCT 27 2004
 BUREAU OF WATER

7 CONTRACTOR'S OR LANDOWNER'S CERTIFICATION: This water well was Constructed under my jurisdiction and was completed on (mo/day/year) 10/20/04 and this record is true to the best of my knowledge and belief. Kansas Water Well Contractor's License No. 179 This Water Well Record was completed on (mo/day/yr) 10/22/04 under the business name of JOB'S WELL SERVICE, INC. by (signature) *Josid Cich*