


WATER WELL RECORD Form WWC-5 KSA 82a-1212

1 LOCATION OF WATER WELL: Fraction Section Number Township Number Range Number  
 COUNTY: FORD SE 1/4 SE 1/4 NE 1/4 16 T 25 S R 25 W

Distance and direction from nearest town or city street address of well if located within city?  
 FROM DODGE CITY - 50 BYPASS & 14TH 8 NORTH, 1 1/2 W & 1/2 S

2 WATER WELL OWNER: HESSMAN, JERRY  
 RR#, St. Address, Box #: ROUTE 2 -- BOX 303 Board of Agriculture, Division of Water Resources  
 City, State, ZIP code: DODGE CITY, KS 67801- Application Number:

3 LOCATE WELL'S LOCATION WITH AN "X" IN SECTION BOX:

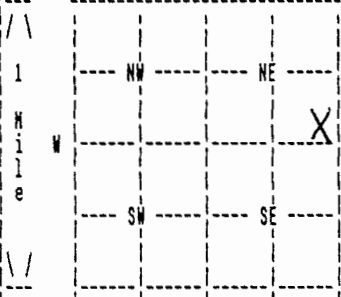

4 DEPTH OF COMPLETED WELL 398 ELEVATION: 0  
 Depth(s) Groundwater Encountered 1. 0 ft. 2. 0 ft. 3. 0 ft.

WELL'S STATIC WATER LEVEL 155 ft. below land surface measured on mo/day/yr 06/18/97  
 Pump test data: Well water was 0 ft. after 0 hours pumping 0 gpm

Estimated Yield 35 gpm: Well water was 0 ft. after 0 hours pumping 0 gpm

Bore Hole Diameter 9 in. to 398 ft., and in. to 0 ft.

WELL WATER TO BE USED AS: DOMESTIC

Was a chemical/bacteriological sample submitted to department? No;  
 If yes, mo/day/yr sample was submitted Water well disinfected? Yes

5 TYPE OF BLANK CASING USED: PVC CASING JOINTS: GLUED  
 Blank casing diameter 5 in. to 398 ft., Dia in. to 0 ft., Dia in. to 0 ft.  
 Casing height above land surface 12 in., weight 200 lbs/ft. Wall thickness or gauge No. 17 21  
 TYPE OF SCREEN OR PERFORATION MATERIAL: PVC  
 SCREEN OR PERFORATION OPENINGS ARE: SAW CUT

SCREEN PERFORATED INTERVALS: From 243 ft. to 263 ft., From 0 ft. to 0 ft.  
 GRAVEL PACK INTERVALS: From 373 ft. to 393 ft., From 0 ft. to 0 ft.  
 From 30 ft. to 398 ft., From 0 ft. to 0 ft.  
 From 0 ft. to 0 ft., From 0 ft. to 0 ft.

6 GROUT MATERIAL BENTONITE  
 Grout Intervals: From 0 ft. to 30 ft., From 0 ft. to 0 ft., From 0 ft. to 0 ft.  
 What is the nearest source of possible contamination: NONE - NEW SITE  
 Direction from well? How many feet? 0

FROM	TO	LITHOLOGIC LOG	FROM	TO	PLUGGING INTERVALS
0	20	TOPSOIL CALACHIE LIMESTONE			
20	40	CALACHIE LIMESTONE BLUE SHALE			
40	120	BLUE SHALE			
120	170	CLAY			
170	200	ROCK LAYERS SANDSTONE			
200	280	SANDSTONE			
280	320	SANDSTONE GRAY CLAY			
320	340	SANDSTONE			
340	360	SANDSTONE GRAY CLAY IN LAYERS			
360	418	SANDSTONE			

7 CONTRACTOR'S OR LANDOWNER'S CERTIFICATION: This water well was Constructed under my jurisdiction and was completed on (mo/day/year) 06/18/97 and this record is true to the best of my knowledge and belief. Kansas Water Well Contractor's license No. 179 This Water Well Record was completed on (mo/day/yr) 06/30/97 under the business name of JOE'S WELL SERVICE, INC. by (signature) *Jessie Creek*

(Continued) WATER WELL RECORD Form WWC-5 KSA 82a-1212

1 LOCATION OF WATER WELL: Fraction Section Number Township Number Range Number  
 COUNTY: FORD SE 1/4 SE 1/4 NE 1/4 16 T 25 S R 25 W

2 WATER WELL OWNER: HESSMAN, JERRY  
 RR#, St. Address, Box #: ROUTE 2 -- BOX 303 Board of Agriculture, Division of Water Resources  
 City, State, ZIP code: DODGE CITY, KS 67801- Application Number:

FROM	TO	LITHOLOGIC LOG
418	0	ROCK LAYERS