


FAXED
8-10-05

at 12:24 PM

1 LOCATION OF WATER WELL: Fraction Section Number Township Number Range Number
 COUNTY: FORD SW 1/4 SW 1/4 SW 1/4 26 T 25 S R 25 B

Distance and direction from nearest town or city street address of well if located within city?
 10592 BRENTON LANE DODGE CITY, KS 67801-

2 WATER WELL OWNER: *Corrected Copy*
 RR#, St. Address, Box #: [REDACTED] Board of Agriculture, Division of Water Resources
 City, State, ZIP code : DODGE CITY, KS 67801- Application Number:

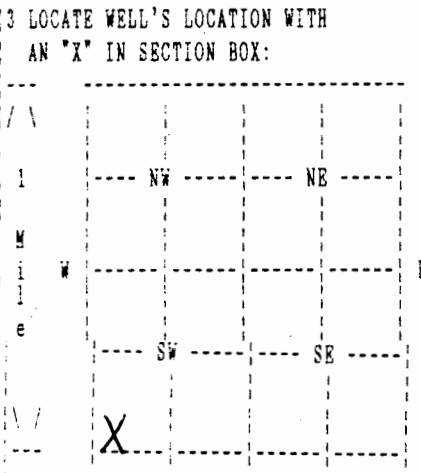

4 DEPTH OF COMPLETED WELL 86 ELEVATION: 0
 Depth(s) Groundwater Encountered 1. 0 ft. 2. 0 ft. 3. 0 ft.
 WELL'S STATIC WATER LEVEL 46 ft. below land surface measured on mo/day/yr 08/15/01
 Pump test data: Well water was 0 ft. after 0 hours pumping 0 gpm
 Estimated Yield 30 gpm: Well water was 0 ft. after 0 hours pumping 0 gpm
 Bore Hole Diameter 10 in. to 86 ft., and in. to 0 ft.
 WELL WATER TO BE USED AS: DOMESTIC
 Was a chemical/bacteriological sample submitted to department? No ;
 If yes, mo/day/yr sample was submitted Water well disinfected? Yes

5 TYPE OF BLANK CASING USED: PVC CASING JOINTS: GLUED
 Blank casing diameter 5 in. to 86 ft., Dia in. to 0 ft., Dia in. to 0 ft.
 Casing height above land surface 12 in., weight 200 lbs/ft. Wall thickness or gauge No. 21
 TYPE OF SCREEN OR PERFORATION MATERIAL: PVC
 SCREEN OR PERFORATION OPENINGS ARE: SAW CUT

SCREEN PERFORATED INTERVALS: From 41 ft. to 81 ft., From 0 ft. to 0 ft.
 From 0 ft. to 0 ft., From 0 ft. to 0 ft.
 GRAVEL PACK INTERVALS: From 25 ft. to 86 ft., From 0 ft. to 0 ft.
 From 0 ft. to 0 ft., From 0 ft. to 0 ft.

6 GROUT MATERIAL BENTONITE
 Grout Intervals: From 5 ft. to 25 ft., From 0 ft. to 0 ft., From 0 ft. to 0 ft.
 What is the nearest source of possible contamination: NONE
 Direction from well? How many feet? 0

FROM	TO	LITHOLOGIC LOG	FROM	TO	PLUGGING INTERVALS
0	20	01 TOPSOIL 05 CLAY 35 CALACHIE			
20	30	05 CLAY 35 CALACHIE 21 LIMESTONE			
30	40	02 FINE SAND			
40	60	37 FIN-COAR SAN 06 SMALL GRAVEL			
60	80	10 FINE-MEDSAND 05 CLAY			
80	90	05 CLAY			
90	100	07 BLUE SHALE			

The casing was raised on this well - pit is below ground level.
Jerry

7 CONTRACTOR'S OR LANDOWNER'S CERTIFICATION: This water well was Reconstructed under my jurisdiction and was completed on (mo/day/year) 08/09/05 and this record is true to the best of my knowledge and belief. Kansas Water Well Contractor's License No. 179 This Water Well Record was completed on (mo/day/yr) 08/10/05 under the business name of JOB'S WELL SERVICE, INC. by (signature) *Judith Cuck*