


1 LOCATION OF WATER WELL: County: Ford Fraction: SE 1/4 SE 1/4 NE 1/4 Section Number: 22 Township Number: T 25 S Range Number: R 25 E/W

Distance and direction from nearest town or city street address of well if located within city?  
Approx. 5.8 Miles North & 1 Miles West of the Intersection of Alt. 50 & 14th Street, Dodge City, KS

2 WATER WELL OWNER: Ford County 01948009 MW-5  
 RR#, St. Address, Box #: 100 Gunsmoke Board of Agriculture, Division of Water Resources  
 City, State, ZIP Code: Dodge City, Kansas 67801 Application Number:

3 LOCATE WELL'S LOCATION WITH AN "X" IN SECTION BOX:

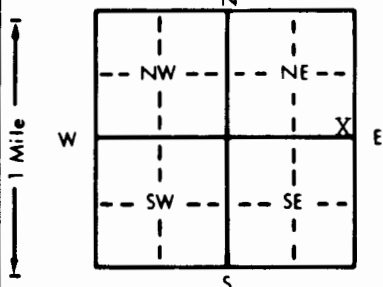

4 DEPTH OF COMPLETED WELL: 75 ft. ELEVATION: 2563.32

Depth(s) Groundwater Encountered 1. .... ft. 2. .... ft. 3. .... ft.  
 WELL'S STATIC WATER LEVEL .. 47.68 .. ft. below land surface measured on mo/day/yr 11/28/94  
 Pump test data: Well water was ..... ft. after ..... hours pumping ..... gpm  
 Est. Yield N/A gpm: Well water was ..... ft. after ..... hours pumping ..... gpm  
 Bore Hole Diameter: 8.25 .. in. to 80 .. ft., and ..... in. to ..... ft.  
 WELL WATER TO BE USED AS: 5 Public water supply 8 Air conditioning 11 Injection well  
 1 Domestic 3 Feedlot 6 Oil field water supply 9 Dewatering 12 Other (Specify below)  
 2 Irrigation 4 Industrial 7 Lawn and garden only  10 Monitoring well  
 Was a chemical/bacteriological sample submitted to Department? Yes.....No..... If yes, mo/day/yr sample was submitted  
 Water Well Disinfected? Yes No

5 TYPE OF BLANK CASING USED: 5 Wrought iron 8 Concrete tile CASING JOINTS: Glued ..... Clamped .....

Blank casing diameter ..... in. to 65 .. ft., Dia ..... in. to ..... ft., Dia ..... in. to ..... ft.  
 Casing height above land surface: 36 .. in., weight ..... lbs./ft. Wall thickness or gauge No. Schedule 40  
 TYPE OF SCREEN OR PERFORATION MATERIAL:  7 PVC 10 Asbestos-cement  
 1 Steel 3 RMP (SR) 6 Asbestos-Cement 9 Other (specify below) Welded .....

SCREEN OR PERFORATION OPENINGS ARE: 5 Gauzed wrapped 8 Saw cut 11 None (open hole)  
 1 Continuous slot  3 Mill slot 6 Wire wrapped 9 Drilled holes  
 2 Louvered shutter 4 Key punched 7 Torch cut 10 Other (specify) .....

SCREEN-PERFORATED INTERVALS: From ..... 65 .. ft. to ..... 75 .. ft., From ..... ft. to ..... ft.  
 GRAVEL PACK INTERVALS: From ..... 63 .. ft. to ..... 75 .. ft., From ..... ft. to ..... ft.

6 GROUT MATERIAL:  1 Neat cement 2 Cement grout  3 Bentonite 4 Other .....

Grout Intervals: From ..... 0 .. ft. to ..... 61 .. ft., From ..... 61 .. ft. to ..... 63 .. ft., From ..... ft. to ..... ft.  
 What is the nearest source of possible contamination:  
 1 Septic tank 4 Lateral lines 7 Pit privy 10 Livestock pens 14 Abandoned water well  
 2 Sewer lines 5 Cess pool 8 Sewage lagoon 11 Fuel storage 15 Oil well/Gas well  
 3 Watertight sewer lines 6 Seepage pit 9 Feedyard 12 Fertilizer storage 16 Other (specify below)  
 13 Insecticide storage  
 Direction from well? How many feet?

FROM	TO	LITHOLOGIC LOG	FROM	TO	PLUGGING INTERVALS
0.0	0.3	Grass			
0.3	2.0	Brown, Silty, Lean to Fat Clay			
2.0	3.5	Brown, Silty Fine Sand			
3.5	12.0	Brown, Sandy Lean Clay			
12.0	18.5	Brown, Sandy, Lean to Fat Clay			
18.5	23.5	Brown, Sandy Lean Clay			
23.5	28.5	Brown, Sandy Lean Clay With Calcareous Zones			
28.5	53.5	Brown, Fine to Medium Sand, Trace Clay With Calcareous Zones			
53.5	58.0	Brown, Fine to Medium Sand With Calcareous Zones			
58.0	80.0	Olive-Brown and Gray, Fine to Medium Sand With Calcareous Zones			

7 CONTRACTOR'S OR LANDOWNER'S CERTIFICATION: This water well was  (1) constructed, (2) reconstructed, or (3) plugged under my jurisdiction and was completed on (mo/day/year) 11/07/94 and this record is true to the best of my knowledge and belief. Kansas Water Well Contractor's License No. 416 This Water Well Record was completed on (mo/day/yr) 11/15/94 under the business name of Terracon Consultants, Inc. by (signature) *Steve Fisher*