

USE TYPEWRITER OR BALL POINT PEN-PRESS FIRMLY, PRINT CLEARLY.

T R EW sec 1/4 1/4 1/4 No.

WATER WELL RECORD  
KSA 82a-1201-1215

*DODGE CITY*


Kansas State Dept. Of Health  
(Water Well Contractors)  
Forbes-Bldg. 740  
Topeka, Kansas 66620

DDD

1 Location of well:	County <b>Ford</b>	Township name <b>Royal</b>	Section number <del>SE 1/4 SE 1/4 SE 1/4</del> <b>2</b>	Town number <b>25</b>	Range number <b>26</b>
---------------------	-----------------------	-------------------------------	---	--------------------------	---------------------------

Distance and direction from nearest town or city:  
**8 mi north, 5 mi west of Dodge City, Ks.**  
Street address of well location if in city:

3 Owner of well:  
**Irvin Brehm & Sons**  
Address: **Offerle, Ks. 67863**

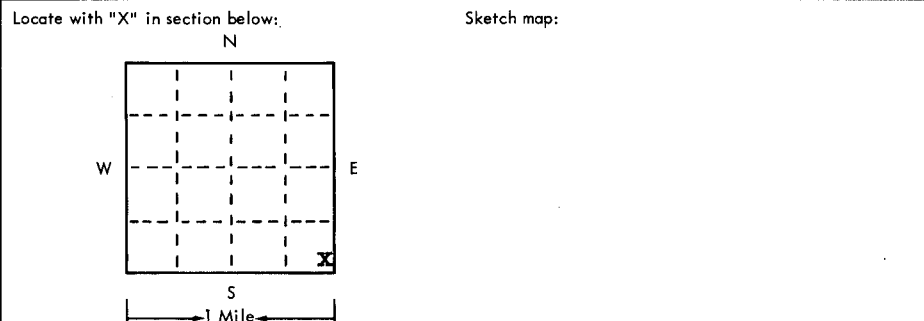

4 Well depth: 98' ft. Date of completion 7-10-75  
Well diameter 7 3/4"

5  Cable tool  Rotary  Driven  Dug  
 Hollow rod  Jetted  Bored  Reverse rotary

6 Use:  Domestic  Public supply  Industry  
 Irrigation  Air conditioning  Commercial  
 Test well

7 Casing: Material Plastic Height: above/below  
Threaded  Welded  Surface 5" in.  
Diam. 5" cemented 250 lbs./ft.  
0 in. to 98 ft. depth! Drive shoe?  Yes  No  
0 in. to     ft. depth!

2 Type and color of material	From	To
Clay	0	20
Gyp	20	60
Clay, broken rock, little sand	60	100
<i>Block 100'</i>		
<i>80</i>		
<i>20' sand</i>		

8 Screen:  
Manufacturer Jess-Lowell  
Type Plastic Dia. 5"  
Slot/gauze 1/16 Length 12  
Set between 78 ft. and 98 ft.  
Fittings:  
Gravel pack  Yes  No Size range of material 1/8x5/8

9 Static water level:  
80 ft. below land surface Date 7-10-75

10 Pumping level below land surfaces:  
    ft. after     hrs. pumping     g.p.m.  
    ft. after     hrs. pumping     g.p.m.  
Estimated maximum yield 20 g.p.m.

11 Water sample submitted:  
 Yes  No Date    

12 Well head completion:  
 Pitless adapter  Inches above grade

13 Well grouted?  Yes  No  
 Neat cement  Bentonite       
Depth: From 0 ft. to 10 ft.

14 Nearest source of possible contamination: NA  
ft.     Direction     Type      
Well disinfected upon completion?  Yes  No

15 Pump:  Not installed  
Manufacturer's name      
Model number     HP     Volts      
Length of drop pipe     ft. capacity     g.m.p.  
Type:  
 Submersible  Turbine  
 Jet  Reciprocating  
 Centrifugal  Other

16 Remarks: elevation

Topography:  
 Hill  
 Slope  
 Upland  
 Valley

*Good drainage*

*2606*  
*100'*  
*2506'*

**High Plains Drilling & Supply, Inc 136**  
Business name  
Address: 102 N 3rd, Garden City, Ks.  
License No.      
Signed: Shady K. Whelan Date 8-11-75  
Accepted: