

DODGE CITY


USE TYPEWRITER OR BALL POINT PEN-PRESS FIRMLY, PRINT CLEARLY.

WATER WELL RECORD
KSA 82a-1201-1215

Kansas Department of Health and Environment-Division of Environment (Water well Contractors) Topeka, Kansas 66620

1. Location of well:	County Ford	Fraction SE 1/4 SE 1/4 SE 1/4	Section number 13	Township number T 25 S	Range number R 26 E/W
----------------------	-----------------------	---	-----------------------------	----------------------------------	---------------------------------

2. Distance and direction from nearest town or city: Street address of well location if in city: East edge of Wright	3. Owner of well: Gaylord Rarden R.R. or street: City, state, zip code: Wright, Kansas 67882
--	--

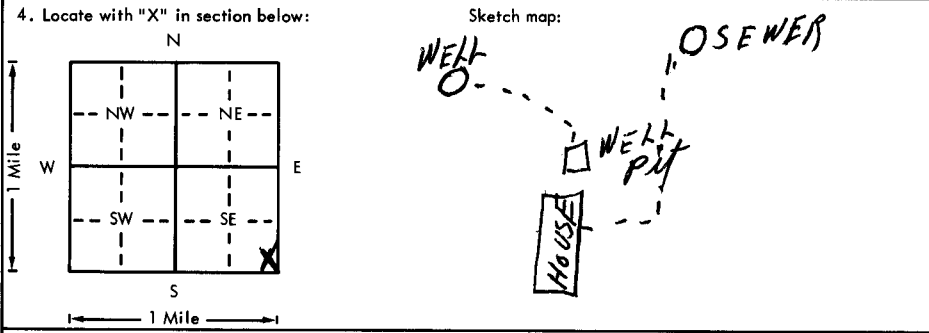

6. Bore hole dia. <u>8</u> in. Completion date _____ Well depth <u>127</u> ft. <u>5-24-78</u>
7. <input checked="" type="checkbox"/> Cable tool <input checked="" type="checkbox"/> Rotary <input type="checkbox"/> Driven <input type="checkbox"/> Dug <input type="checkbox"/> Hollow rod <input type="checkbox"/> Jetted <input type="checkbox"/> Bored <input type="checkbox"/> Reverse rotary
8. Use: <input checked="" type="checkbox"/> Domestic <input type="checkbox"/> Public supply <input type="checkbox"/> Industry <input type="checkbox"/> Irrigation <input type="checkbox"/> Air conditioning <input type="checkbox"/> Stock <input type="checkbox"/> Lawn <input type="checkbox"/> Oil field water <input type="checkbox"/> Other
9. Casing: Material <u>RMP</u> Height: Above or below <u>XXX</u> Threaded <input type="checkbox"/> Welded <input type="checkbox"/> Surface <u>12</u> in. RMP <u>XX</u> PVC <input type="checkbox"/> Weight _____ lbs./ft. Dia. <u>5</u> in. to <u>127</u> ft. depth Wall Thickness: inches or Dia. _____ in. to _____ ft. depth gage No. <u>250</u>

5. Type and color of material	From	To
Top soil & clay	0	15
Clay	15	45
Clay & white rock layers	45	75
Clay, white rock & fine sand	75	90
Fine sand to medium sand	90	105
Medium to coarse sand & clay layers	105	120
Clay	120	127
(Use a second sheet if needed)		

10. Screen: Manufacturer's name <u>Sunflower</u> Type <u>RMP</u> Dia. <u>5"</u> Slot/gauge <u>1/8"</u> Length <u>20 ft.</u> Set between <u>102</u> ft. and <u>122</u> ft. Gravel pack? <u>yes</u> Size range of material <u>1/4"</u>
11. Static water level: _____ mo./day/yr. <u>94</u> ft. below land surface Date <u>5-24-78</u>
12. Pumping level below land surfaces: <u>95</u> ft. after <u>1</u> hrs. pumping <u>20</u> g.p.m. _____ ft. after _____ hrs. pumping _____ g.p.m. Estimated maximum yield <u>30</u> g.p.m.
13. Water sample submitted: _____ mo./day/yr. <input type="checkbox"/> Yes <input checked="" type="checkbox"/> No Date _____
14. Well head completion: <input checked="" type="checkbox"/> Pitless adapter <u>12</u> inches above grade
15. Well grouted? <u>yes</u> With: <input checked="" type="checkbox"/> Neat cement <input type="checkbox"/> Bentonite <input type="checkbox"/> Concrete Depth: From <u>5</u> ft. to <u>15</u> ft.
16. Nearest source of possible contamination: ft. <u>60</u> Direction <u>east</u> Type <u>septic</u> Well disinfected upon completion? <input checked="" type="checkbox"/> Yes <input type="checkbox"/> No
17. Pump: _____ Not installed Manufacturer's name <u>Goulds</u> Model number <u>7EH</u> HP <u>3/4</u> Volts <u>230</u> Length of drop pipe <u>120</u> ft. capacity <u>7</u> g.p.m. Type: <input checked="" type="checkbox"/> Submersible <input type="checkbox"/> Turbine <input type="checkbox"/> Jet <input type="checkbox"/> Reciprocating <input type="checkbox"/> Centrifugal <input type="checkbox"/> Other

18. Elevation: Topography: <input type="checkbox"/> Hill <input type="checkbox"/> Slope <input checked="" type="checkbox"/> Upland <input type="checkbox"/> Valley	19. Remarks: Was in process of being hooked up to City Sewer. 2613 TOPO
---	---

20. Water well contractor's certification: This well was drilled under my jurisdiction and this report is true to the best of my knowledge and belief. Joe's Well Service License No. <u>179</u> Business name _____ Address <u>Box 174 Cimarron, Ks.</u> Signed <u>Larry Crick</u> Date <u>5-24-78</u> Authorized representative
--

25
13 SE 26 E
1/4 1/4 1/4