

# Frank Stauth


USE TYPEWRITER OR BALL POINT PEN-PRESS FIRMLY, PRINT CLEARLY.

WATER WELL RECORD  
KSA 82a-1201-1215

Kansas Department of Health and Environment-Division of Environment  
(Water well Contractors)  
Topeka, Kansas 66620

**CAC**  
Near center of SW  $\frac{1}{4}$

1. Location of well:	County <b>Ford</b>	Fraction <b>SW 1/4 NE 1/4 SW 1/4</b>	Section number <b>22</b>	Township number <b>T 25 S R 26 E/W</b>	Range number <b>26</b>
2. Distance and direction from nearest town or city: <b>4 1/2 mi north &amp; 1 mi east of Howell, Ks</b> Street address of well location if in city:			3. Owner of well: <b>Frank Stauth</b> R.R. or street: <b>908 6th Ave.</b> City, state, zip code: <b>Dodge City, Kansas</b>		

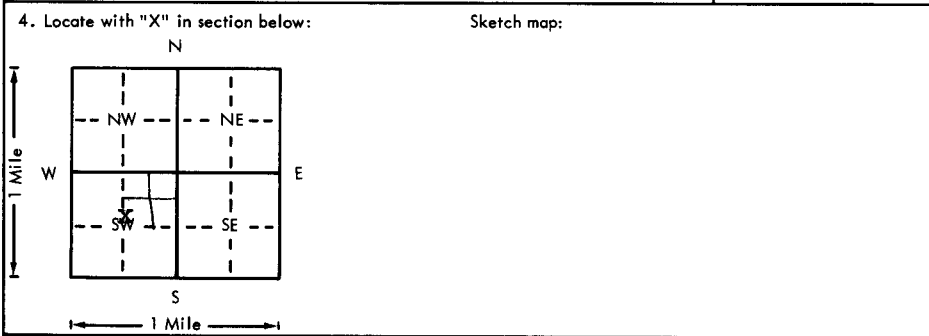

6. Bore hole dia. 28 in. Completion date \_\_\_\_\_  
Well depth 158 ft. 12-27-77

7. Cable tool  Rotary  Driven  Dug  
 Hollow rod  Jetted  Bored  Reverse rotary

8. Use:  Domestic  Public supply  Industry  
 Irrigation  Air conditioning  Stock  
 Lawn  Oil field water  Other

9. Casing: Material metal Height: Above or below  
Threaded  Welded  Surface 10 in.  
RMP  PVC  Weight 31.66 lbs./ft.  
Dia. 16 in. to 158 ft. depth Wall Thickness \_\_\_\_\_ inches or  
Dia. \_\_\_\_\_ in. to \_\_\_\_\_ ft. depth gage No. 188

5. Type and color of material	From	To
<del>Surface</del>	<del>0</del>	<del>3</del>
<del>Brown clay</del>	<del>3</del>	<del>16</del>
<del>Green and brown calcareous clay</del>	<del>16</del>	<del>58</del>
<del>Med. to coarse sand and gravel</del>	<del>58</del>	<del>83</del>
<del>Clay with 20% big gravel and sand mixed</del>	<del>83</del>	<del>90</del>
<del>Sandy brown clay</del>	<del>90</del>	<del>100</del>
<del>Med. sand and fine gravel with 15% clay</del>	<del>100</del>	<del>110</del>
<del>Clay</del>	<del>110</del>	<del>112</del>
<del>Med. sand with 20% clay mixed</del>	<del>112</del>	<del>116</del>
<del>Med. lite sand</del>	<del>116</del>	<del>120</del>
<del>Good fine to med. sand and fine gravel</del>	<del>120</del>	<del>150</del>
<del>Med. sand and fine gravel</del>	<del>150</del>	<del>155</del>
<del>Blue shale</del>	<del>155</del>	<del>160</del>
<b>BRICK 155'</b>		
<b>75'</b>		
<b>80' sat fluck</b>		
<b>in Og</b>		
(Use a second sheet if needed)		

10. Screen: Manufacturer's name W. A. Brown  
Type 17% Free-flo Dia. 16  
Slot/gauze 1/8 Length 80  
Set between 78 ft. and 158 ft.  
\_\_\_\_\_ ft. and \_\_\_\_\_ ft.  
Gravel pack?  yes Size range of material 1/2 down

11. Static water level: \_\_\_\_\_ mo./day/yr.  
75 ft. below land surface Date 12-5-77

12. Pumping level below land surfaces:  
118 ft. after 1.5 hrs. pumping 800 g.p.m.  
105 ft. after 1.5 hrs. pumping 1000 g.p.m.  
Estimated maximum yield 1000 g.p.m.

13. Water sample submitted: \_\_\_\_\_ mo./day/yr.  
Yes  No  Date \_\_\_\_\_

14. Well head completion:  
 Pitless adapter X inches above grade

Well grouted? no  
With: \_\_\_\_\_ Neat cement \_\_\_\_\_ Bentonite \_\_\_\_\_ Concrete  
Depth: From \_\_\_\_\_ ft. to \_\_\_\_\_ ft.

16. Nearest source of possible contamination: ### Field  
ft. \_\_\_\_\_ Direction \_\_\_\_\_ Type \_\_\_\_\_  
Well disinfected upon completion? Yes  No

17. Pump:  Not installed  
Manufacturer's name \_\_\_\_\_  
Model number \_\_\_\_\_ HP \_\_\_\_\_ Volts \_\_\_\_\_  
Length of drop pipe \_\_\_\_\_ ft. capacity \_\_\_\_\_ g.p.m.  
Type:  
 Submersible  Turbine  
 Jet  Reciprocating  
 Centrifugal  Other

18. Elevation: \_\_\_\_\_

19. Remarks:  
**10' of concrete and motor slab to be installed by the customer, he knows this is a regulation**  
*Frank Stauth Jr. 1010*

20. Water well contractor's certification:  
This well was drilled under my jurisdiction and this report is true to the best of my knowledge and belief.  
**Ace-Hi International** 190  
Business name License No.  
Address **Dodge City, Kansas**  
Signed *Carl B. Smith* Date 12-27-77  
Authorized representative

25  
26  
22  
1/4 1/4  
CSU  
27

155  
2475