

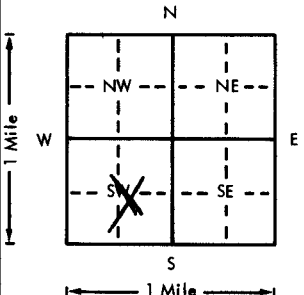
USE TYPEWRITER OR BALL POINT PEN—PRESS FIRMLY, PRINT CLEARLY.

DODGE CITY SW

WATER WELL RECORD  
KSA 82a-1201-1215

Kansas Department of Health and Environment—Division of Environment  
(Water well Contractors)  
Topeka, Kansas 66620

CAC

1. Location of well:		County <b>FORD</b>	Fraction <b>SW 1/4 NE 1/4 SW 1/4</b>	Section number <b>24</b>	Township number <b>T 25 S R 26</b>	Range number <b>26</b>
2. Distance and direction from nearest town or city: <b>North of Howell to deadend 2 1/2 east 2 north 3/8 east</b> Street address of well location if in city:			3. Owner of well: <b>Mark Orebaugh</b> R.R. or street: <b>2401 5 Ave.</b> City, state, zip code: <b>Dodge City, Ks. 67801</b>			
4. Locate with "X" in section below: Sketch map: 			6. Bore hole dia. <b>26</b> in. Completion date <b>12-31-75</b> Well depth <b>95</b> ft.			
5. Type and color of material			From	To	7. <input type="checkbox"/> Cable tool <input type="checkbox"/> Rotary <input type="checkbox"/> Driven <input type="checkbox"/> Dug <input type="checkbox"/> Hollow rod <input type="checkbox"/> Jetted <input type="checkbox"/> Bored <input checked="" type="checkbox"/> Reverse rotary	
<b>NOT TO BLOCK</b>					8. Use: <input type="checkbox"/> Domestic <input type="checkbox"/> Public supply <input type="checkbox"/> Industry <input checked="" type="checkbox"/> Irrigation <input type="checkbox"/> Air conditioning <input type="checkbox"/> Stock <input type="checkbox"/> Lawn <input type="checkbox"/> Oil field water <input type="checkbox"/> Other	
					9. Casing: Material <b>steel</b> Height: Above or below Threaded <input type="checkbox"/> Welded <input checked="" type="checkbox"/> Surface <b>12</b> in. RMP <input type="checkbox"/> PVC <input type="checkbox"/> Weight <b>36.87</b> lbs./ft. Dia. <b>16</b> in. to <b>96</b> ft. depth Wall Thickness: inches or Dia. <input type="checkbox"/> in. to <input type="checkbox"/> ft. depth Gage No. <input type="checkbox"/>	
					10. Screen: Manufacturer's name <b>Johnson Division</b> Type <b>Galv.</b> Dia. <b>16"</b> Slot/gauze <b>100</b> Length <b>20'</b> Set between <b>65</b> ft. and <b>85</b> ft. Perf. <b>86-95</b> ft. and <input type="checkbox"/> ft. Gravel pack? <input checked="" type="checkbox"/> Size range of material <b>1/2 to 1/4 in.</b>	
					11. Static water level: <input type="checkbox"/> mo./day/yr. <b>68</b> ft. below land surface Date <b>11-8-75</b>	
					12. Pumping level below land surfaces: <b>85</b> ft. after <b>3</b> hrs. pumping <b>308</b> g.p.m. <input type="checkbox"/> ft. after <input type="checkbox"/> hrs. pumping <input type="checkbox"/> g.p.m. Estimated maximum yield <b>300</b> g.p.m.	
					13. Water sample submitted: <input type="checkbox"/> mo./day/yr. <input type="checkbox"/> Yes <input checked="" type="checkbox"/> No Date <input type="checkbox"/>	
					14. Well head completion: <b>12</b> inches above grade <input type="checkbox"/> Pitless adapter	
					15. Well grouted? <input checked="" type="checkbox"/> yes With: <input type="checkbox"/> Neat cement <input type="checkbox"/> Bentonite <input checked="" type="checkbox"/> Concrete Depth: From <b>0</b> ft. to <b>10</b> ft.	
					16. Nearest source of possible contamination: <b>N/A</b> ft. <input type="checkbox"/> Direction <input type="checkbox"/> Type <input checked="" type="checkbox"/> Well disinfected upon completion? <input type="checkbox"/> Yes <input type="checkbox"/> No	
					17. Pump: <input type="checkbox"/> Not installed Manufacturer's name <b>GouldsUS Pump</b> Model number <b>UH 64 JL MP2</b> Volts <b>2</b> Length of drop pipe <b>42</b> ft. capacity <b>300</b> g.p.m. Type: <input checked="" type="checkbox"/> Submersible <input checked="" type="checkbox"/> Turbine <input type="checkbox"/> Jet <input type="checkbox"/> Reciprocating <input type="checkbox"/> Centrifugal <input type="checkbox"/> Other	
(Use a second sheet if needed)						
18. Elevation:  Topography: <input type="checkbox"/> Hill <input checked="" type="checkbox"/> Slope <input type="checkbox"/> Upland <input type="checkbox"/> Valley	19. Remarks:  <b>2612</b>  <b>1090</b>		20. Water well contractor's certification: This well was drilled under my jurisdiction and this report is true to the best of my knowledge and belief.  <b>Winter Wilson Drilling 208</b> Business name License No. <input type="checkbox"/> Address <b>P.O. Box A Garden City, KS</b> Signed <b>Arne K. Jensen</b> Date <b>9-1-76</b> Authorized representative			

-75

25 26 27 

*The Professionals*

# MINTER-WILSON DRILLING CO.

INCORPORATED

Water Systems  
Complete Installation  
and Repairing

Phone 276-8269 • P.O. Box 493 • GARDEN CITY, KANSAS 67846

MARK OREBAUGH  
Ford County  
8-11-75

Location: 200 yds. east of No. 5 (SW $\frac{1}{4}$  24-25-26)

Test # 6

0	1	Top Soil
1	22	Brown Clay
22	35	Brown Clay & Brown Rock, Small Streaks of fine Sand
35	55	Brown Clay & White Rock (Hard)
55	83	Fine to Med. Sand & Gravel (Loose)
83	95	Brown Clay & White Rock
95	110	Brown & Yellow Clay with streaks of white rock (Hard)

Static Water Level; 65'

T.D. 95'