


1 LOCATION OF WATER WELL: County: Ford Fraction: NE 1/4 SE 1/4 SE 1/4 Section Number: 32 Township Number: T 25 S Range Number: R 26 EW

Distance and direction from nearest town or city street address of well if located within city? From Howell, Ks. - 2 1/2 miles North, 1/2 mile West and 1/2 mile North

2 WATER WELL OWNER: Carl Yeager RR#, St. Address, Box #: Route #2 -- Box 372 City, State, ZIP Code: Dodge City, Kansas 67801 Board of Agriculture, Division of Water Resources Application Number:

3 LOCATE WELL'S LOCATION WITH AN "X" IN SECTION BOX:

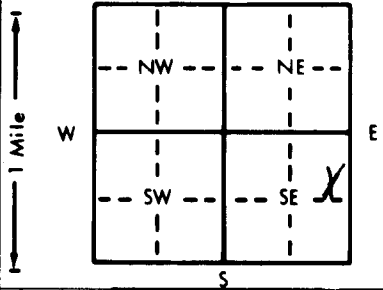

4 DEPTH OF COMPLETED WELL: 233 ft. ELEVATION: ... WELL'S STATIC WATER LEVEL: 109 ft. below land surface measured on mo/day/yr 9-8-88

Depth(s) Groundwater Encountered ... Pump test data: Well water was ... Est. Yield: 65 gpm ... Bore Hole Diameter: 10 in. to 233 ft. ... WELL WATER TO BE USED AS: 5 Public water supply, 8 Air conditioning, 11 Injection well, 1 Domestic, 3 Feedlot, 6 Oil field water supply, 9 Dewatering, 12 Other (Specify below), 2 Irrigation, 4 Industrial, 7 Lawn and garden only, 10 Observation well. Was a chemical/bacteriological sample submitted to Department? Yes... No... XX... If yes, mo/day/yr sample was submitted Water Well Disinfected? Yes XX No

5 TYPE OF BLANK CASING USED: 1 Steel, 3 RMP (SR), 2 PVC, 4 ABS, 5 Wrought iron, 6 Asbestos-Cement, 7 Fiberglass, 8 Concrete tile, 9 Other (specify below), CASING JOINTS: Glued XX, Clamped, Welded, Threaded.

Blank casing diameter: 5 in. to 233 ft., Dia. ... Casing height above land surface: 12 in., weight 200 psi, lbs./ft. Wall thickness or gauge No. SDR 21

TYPE OF SCREEN OR PERFORATION MATERIAL: 1 Steel, 3 Stainless steel, 2 Brass, 4 Galvanized steel, 5 Fiberglass, 6 Concrete tile, 7 PVC, 8 RMP (SR), 9 ABS, 10 Asbestos-cement, 11 Other (specify), 12 None used (open hole)

SCREEN OR PERFORATION OPENINGS ARE: 1 Continuous slot, 2 Louvered shutter, 3 Mill slot, 4 Key punched, 5 Gauzed wrapped, 6 Wire wrapped, 7 Torch cut, 8 Saw cut, 9 Drilled holes, 11 None (open hole), 10 Other (specify)

SCREEN-PERFORATED INTERVALS: From 209 ft. to 229 ft. GRAVEL PACK INTERVALS: From 25 ft. to 233 ft.

6 GROUT MATERIAL: 1 Neat cement, 2 Cement grout, 3 Bentonite, 4 Other hole plug. Grout Intervals: From 5 ft. to 25 ft.

What is the nearest source of possible contamination: 1 Septic tank, 2 Sewer lines, 3 Watertight sewer lines, 4 Lateral lines, 5 Cess pool, 6 Seepage pit, 7 Pit privy, 8 Sewage lagoon, 9 Feedyard, 10 Livestock pens, 11 Fuel storage, 12 Fertilizer storage, 13 Insecticide storage, 14 Abandoned water well, 15 Oil well/Gas well, 16 Other (specify below). Direction from well? Southeast How many feet? 90


7 CONTRACTOR'S OR LANDOWNER'S CERTIFICATION: This water well was (1) constructed, (2) reconstructed, or (3) plugged under my jurisdiction and was completed on (mo/day/year) 9-9-88 and this record is true to the best of my knowledge and belief. Kansas Water Well Contractor's License No. 179. This Water Well Record was completed on (mo/day/yr) 10-5-88 under the business name of Joe's Well Service, Inc. Cimarron, Ks. by (signature) Larry Crick

INSTRUCTIONS: Use typewriter or ball point pen. PLEASE PRESS FIRMLY and PRINT clearly. Please fill in blanks, underline or circle the correct answers. Send top three copies to Kansas Department of Health and Environment, Bureau of Water Protection, Topeka, Kansas 66620-7320, Telephone: 913-862-9360. Send one to WATER WELL OWNER and retain one for your records.