


WATER WELL RECORD Form WWC-5 KSA 82a-1212

1 LOCATION OF WATER WELL:	Fraction	Section Number	Township Number	Range Number
COUNTY: GRAY	SE 1/4 SE 1/4 SW 1/4	16	1 25 S	R 27 W

Distance and direction from nearest town or city street address of well if located within city?
FROM CIMARRON - 1 NORTH ON HIGHWAY 23 - 2 1/2 E, 3M & 1/2 E

2 WATER WELL OWNER: NIEMER, FLORA MRS.
RR#, St. Address, Box #: # NATHAN ENGLISH
City, State, ZIP code : CIMARRON, KS 67835- Board of Agriculture, Division of Water Resources
Application Number:

3 LOCATE WELL'S LOCATION WITH
AN "X" IN SECTION BOX:

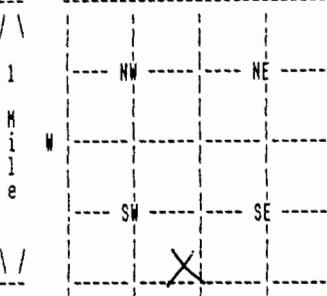

4 DEPTH OF COMPLETED WELL 135 ELEVATION: 0
Depth(s) Groundwater Encountered 1. 0 ft. 2. 0 ft. 3. 0 ft.

WELL'S STATIC WATER LEVEL 0 ft. below land surface measured on mo/day/yr
Pump testdata: Well water was 0 ft. after 0 hours pumping 0 gpm

Estimated Yield 0 gpm: Well water was 0 ft. after 0 hours pumping 0 gpm

Bore Hole Diameter in. to 0 ft., and in. to 0 ft.

WELL WATER WAS: DOMESTIC
Was a chemical/bacteriological sample submitted to department? No ;
If yes, mo/day/yr sample was submitted Water well disinfected? Yes

5 TYPE OF BLANK CASING USED: STEEL CASING JOINTS:
Blank casing diameter 4 in. to 135 ft.. Dia in. to 0 ft., Dia in. to 0 ft.
Casing height above land surface 0 in., weight 0 lbs/ft. Wall thickness or gauge No.

TYPE OF SCREEN OR PERFORATION MATERIAL:

SCREEN OR PERFORATION OPENINGS ARE:

SCREEN PERFORATED INTERVALS: From 0 ft. to 0 ft., From 0 ft. to 0 ft.

From 0 ft. to 0 ft., From 0 ft. to 0 ft.

GRAVEL PACK INTERVALS: From 0 ft. to 0 ft., From 0 ft. to 0 ft.

From 0 ft. to 0 ft., From 0 ft. to 0 ft.

6 GROUT MATERIAL BENTONITE
Grout Intervals: From 0 ft. to 0 ft., From 0 ft. to 0 ft., From 0 ft. to 0 ft.
What is the nearest source of possible contamination: NONE
Direction from well? How many feet? 0

FROM	TO	LITHOLOGIC LOG	FROM	TO	PLUGGING INTERVALS
			0	15	BENTONITE
			15	100	FILL SAND
			100	110	BENTONITE GROUT
			110	135	FILL SAND
			0	0	
			0	0	
			0	0	
			0	0	

7 CONTRACTOR'S OR LANDOWNER'S CERTIFICATION: This water well was Plugged under my jurisdiction and was completed on (mo/day/year) 03/20/97 and this record is true to the best of my knowledge and belief. Kansas Water Well Contractor's License No. 179 This Water Well Record was completed on (mo/day/yr) 04/01/97 under the business name of JOE'S WELL SERVICE, INC. by (signature) *Joe's Well Service, Inc.*