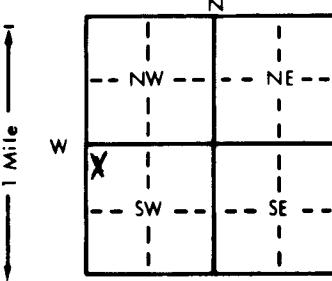


1 LOCATION OF WATER WELL:		Fraction NW $\frac{1}{4}$ NW $\frac{1}{4}$ SW $\frac{1}{4}$	Section Number 23	Township Number T 25 S	Range Number R 27 EW
---------------------------	--	--	----------------------	---------------------------	-------------------------

Distance and direction from nearest town or city street address of well if located within city?

From Cimarron, Ks. - 1 mile North, $4\frac{1}{2}$ miles East and $2\frac{1}{2}$ miles North

2 WATER WELL OWNER: Francis Johnson

RR#, St. Address, Box #: Board of Agriculture, Division of Water Resources
City, State, ZIP Code : Cimarron, Kansas 67835 Application Number:3 LOCATE WELL'S LOCATION WITH 4 DEPTH OF COMPLETED WELL 235 ft. ELEVATION:
AN "X" IN SECTION BOX:

Depth(s) Groundwater Encountered 1 ft. 2 ft. 3 ft. ft.

WELL'S STATIC WATER LEVEL 106 ft. below land surface measured on mo/day/yr 8-3-88

Pump test data: Well water was ft. after hours pumping gpm

Est. Yield 50 gpm: Well water was ft. after hours pumping gpm

Bore Hole Diameter 8 in. to 235 ft., and in. to ft.

WELL WATER TO BE USED AS: 5 Public water supply 8 Air conditioning 11 Injection well

1 Domestic 3 Feedlot 6 Oil field water supply 9 Dewatering 12 Other (Specify below)

2 Irrigation 4 Industrial 7 Lawn and garden only 10 Observation well

Was a chemical/bacteriological sample submitted to Department? Yes XX No XX If yes, mo/day/yr sample was submitted Water Well Disinfected? Yes XX No XX

5 TYPE OF BLANK CASING USED: 5 Wrought iron 8 Concrete tile CASING JOINTS: Glued XX Clamped

1 Steel 3 RMP (SR) 6 Asbestos-Cement 9 Other (specify below) Welded

2 PVC 4 ABS 7 Fiberglass Threaded

Blank casing diameter 5 in. to 235 ft., Dia. in. to ft., Dia. in. to ft.

Casing height above land surface 12 in., weight 190 psi lbs./ft. Wall thickness or gauge No. SDR 21

TYPE OF SCREEN OR PERFORATION MATERIAL: 7 PVC 10 Asbestos-cement

1 Steel 3 Stainless steel 5 Fiberglass 8 RMP (SR) 11 Other (specify)

2 Brass 4 Galvanized steel 6 Concrete tile 9 ABS 12 None used (open hole)

SCREEN OR PERFORATION OPENINGS ARE: 5 Gauzed wrapped 8 Saw cut 11 None (open hole)

1 Continuous slot 3 Mill slot 6 Wire wrapped 9 Drilled holes

2 Louvered shutter 4 Key punched 7 Torch cut 10 Other (specify)

SCREEN-PERFORATED INTERVALS: From 210 ft. to 230 ft., From ft. to ft.

From ft. to ft., From ft. to ft.

GRAVEL PACK INTERVALS: From 30 ft. to 235 ft., From ft. to ft.

From ft. to ft., From ft. to ft.

6 GROUT MATERIAL: 1 Neat cement 2 Cement grout 3 Bentonite 4 Other & hole plug

Grout Intervals: From 5 ft. to 30 ft., From ft. to ft., From ft. to ft., From ft. to ft.

What is the nearest source of possible contamination: none 10 Livestock pens 14 Abandoned water well

1 Septic tank 4 Lateral lines 7 Pit privy 11 Fuel storage 15 Oil well/Gas well

2 Sewer lines 5 Cess pool 8 Sewage lagoon 12 Fertilizer storage 16 Other (specify below)

3 Watertight sewer lines 6 Seepage pit 9 Feedyard 13 Insecticide storage

How many feet?

Direction from well?

FROM	TO	LITHOLOGIC LOG	FROM	TO	LITHOLOGIC LOG
0	15	Top soil & clay			
15	30	Clay			
30	45	Clay & fine sand			
45	60	Fine sand & rock layers			
60	75	Fine sand			
75	90	Fine to medium sand with some coarse gravel			
90	100	Medium to coarse sand			
100	120	Clay & fine sand			
120	135	Fine sand			
135	150	Fine to medium sand			
150	165	Medium with some coarse sand & clay (3 ft.)			
165	195	Fine to medium sand			
195	230	Fine to medium sand with some coarse sand			
230	240	Clay & blue shale			

7 CONTRACTOR'S OR LANDOWNER'S CERTIFICATION: This water well was (1) constructed, (2) reconstructed, or (3) plugged under my jurisdiction and was completed on (mo/day/year) 8-4-88 and this record is true to the best of my knowledge and belief. Kansas

Water Well Contractor's License No. 179 This Water Well Record was completed on (mo/day/yr) 9-6-88 under the business name of Joe's Well Service, Inc. Cimarron, Ks. by (signature) *Judie Cick*

INSTRUCTIONS: Use typewriter or ball point pen. PLEASE PRESS FIRMLY and PRINT clearly. Please fill in blanks, underline or circle the correct answers. Send top three copies to Kansas Department of Health and Environment, Bureau of Water Protection, Topeka, Kansas 66620-7320, Telephone: 913-862-9360. Send one to WATER WELL OWNER and retain one for your records.