

WATER WELL PLUGGING RECORD Form WWC-5P KSA 82a-1212 ID NO.

1 LOCATION OF WATER WELL: Fraction SE 1/4 SE 1/4 SE 1/4 SE 1/4 Section Number 8 Township Number 25 T S Range Number 27 E W
 County: Gray


Street/Rural Address of Well Location; if unknown, distance & direction from nearest town or intersection: If at owner's address, check here Township Forste
08-0255-027W

Global Positioning Systems (GPS) information:
 Latitude: 37.885971 (in decimal degrees)
 Longitude: 100.3011824 (in decimal degrees)
 Elevation: 2746
 Datum: WGS84, NAD83, NAD27
 Collection Method:

2 WATER WELL OWNER: Todd Hamilton
 RR#, St. Address, Box #: 20506 22nd Rd
 City, State ZIP Code: Ensign KS 67841

GPS unit (Make/Model: Garmin)
 Digital Map/Photo, Topographic Map, Land Survey
 Est. Accuracy: <3 m, 3-5 m, 5-15 m, >15 m

3 MARK WELL'S LOCATION WITH AN "X" IN SECTION BOX:

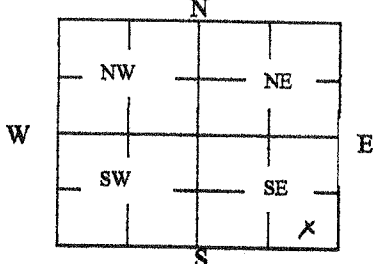

4 DEPTH OF WELL 200 ft.
 WELL'S STATIC WATER LEVEL 185 ft.

- WELL WAS USED AS:
- Domestic
 - Irrigation
 - Feedlot
 - Industrial
 - Public Water Supply
 - Oil Field Water Supply
 - Domestic (Lawn & Garden)
 - Air Conditioning
 - Dewatering
 - Monitoring
 - Injection Well
 - Other _____

Was a chemical/bacteriological sample submitted to Department? Yes No

5 TYPE OF BLANK CASING USED:

- Steel
- PVC
- RMP (SR)
- ABS
- Wrought
- Asbestos-Cement
- Fiberglass
- Concrete Tile
- Other (Specify below) _____

Blank casing diameter 5 in. Was casing pulled? Yes No If yes, how much _____
 Casing height above or below land surface 48 in.

6 GROUT PLUG MATERIAL: Neat cement Cement grout Bentonite Other _____

Grout Plug Intervals: From 185 ft. to 181 ft., From 4 ft. to 0 ft., From _____ ft. to _____ ft.

- What is the nearest source of possible contamination:
- Septic tank
 - Sewer lines
 - Watertight sewer lines
 - Lateral lines
 - Cess pool
 - Seepage pit
 - Pit privy
 - Sewage lagoon
 - Feedyard
 - Livestock pens
 - Fuel storage
 - Fertilizer storage
 - Insecticide storage
 - Abandoned water well
 - Oil well/Gas well
 - Other (specify below) _____
- Direction from well? _____
 How many feet? _____

FROM	TO	PLUGGING MATERIALS	FROM	TO	PLUGGING MATERIALS
<u>200</u>	<u>185</u>	<u>Clean Fill Sand</u>			
<u>185</u>	<u>181</u>	<u>Bentonite</u>			
<u>181</u>	<u>4</u>	<u>Clean Fill Sand</u>			
<u>4</u>	<u>0</u>	<u>Bentonite</u>			

7 CONTRACTOR'S OR LANDOWNER'S CERTIFICATION: This water well was plugged under my jurisdiction and was completed on (mo/day/year) 3-16-15 and this record is true to the best of my knowledge and belief. Kansas Water Well Contractor's License No. 846. This Water Well Record was completed on (mo/day/year) 3-17-15 under the business name of Nash Water Well Service, LLC by (signature) [Signature]

INSTRUCTIONS: Use typewriter or ballpoint pen. Please press firmly and print clearly. Please fill in blanks, underline or circle the correct answers. Send top three copies to Kansas Department of Health and Environment, Bureau of Water, Geology Section, 1000 SW Jackson St., Ste. 420, Topeka, Kansas 66612-1367. Telephone: 785/296-5524. Send one to Water Well Owner and retain one for your records. Visit us at <http://www.kdheks.gov/waterwell/index.html>.