

USE TYPEWRITER OR BALL POINT PEN-PRESS FIRMLY, PRINT CLEARLY.

T R EW sec 1/4 1/4 1/4 No.


WATER WELL RECORD
KSA 82a-1201-1215

Kansas State Dept. Of Health
(Water Well Contractors)
Forbes-Bldg. 740
Topeka, Kansas 66620

1 Location of well:	County Gray	Township name Logan	Fraction SE 1/4	Section number # 5	Town number T #25 S	Range number R# 29 W
---------------------	-----------------------	-------------------------------	---------------------------	------------------------------	-------------------------------	--------------------------------

Distance and direction from nearest town or city: **1/2 E. of Charleston**
2 1/2 N. and 1 1/2 E. of Charleston
Street address of well location if in city:

3 Owner of well: **Dave Hewes**
Address: **Ingalls, Kansas 67853**

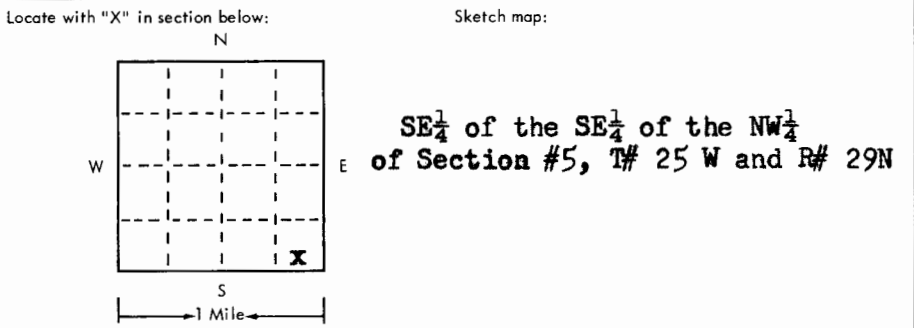

4 Well depth: **275** ft. Date of completion **5-25-75**
Well diameter **8** in.

5 Cable tool Rotary Driven Dug
 Hollow rod Jetted Bored Reverse rotary

6 Use: Domestic Public supply Industry
 Irrigation Air conditioning Commercial
 Test well

7 Casing: Material **RMP** Height: above/below **XXX**
Threaded Welded Surface **12** in.
Diam. _____ Weight _____ lbs./ft. _____
5 in. to **275** ft. depth! Drive shoe? Yes No
_____ in. to _____ ft. depth!

2 Type and color of material	From	To
Top soil & clay	0	15
Clay	15	30
Clay	30	45
Clay & medium sand dry	45	60
Coarse sand - rock	60	75
Fine sand	75	90
" "	90	105
" "	105	120
" "	120	135
" "	135	150
Fine sand & clay	150	165
Clay	165	180
Clay & medium to coarse sand	180	195
Medium to coarse sand	195	210
Fine to medium sand	210	225
Medium Sand (use a second sheet if needed)	225	240

8 Screen: Manufacturer **Jess & Lowell**
Type **RMP** Dia. **5"**
Slot gauze **1/8"** Length **20ft.**
Set between **250** ft. and **270** ft.
Fittings: Gravel pack Yes No Size range of material **1/4"**

9 Static water level: **129** ft. below land surface Date **5-25-75**

10 Pumping level below land surfaces:
129 ft. after **1 1/2** hrs. pumping **50** g.p.m.
_____ ft. after _____ hrs. pumping _____ g.p.m.
Estimated maximum yield **75** g.p.m.

11 Water sample submitted:
 Yes No Date _____

12 Well head completion: **None**
 Pitless adapter Inches above grade

13 Well grouted? Yes No
 Neat cement Bentonite _____
Depth: From **0** ft. to **15** ft.

14 Nearest source of possible contamination: **Chemical tanks**
ft. **100** Direction **West** Type **Chemical tanks**
Well disinfected upon completion? Yes No

15 Pump: Not installed
Manufacturer's name **Flint & Walling**
Model number **7BA12** HP **3/4** Volts **230**
Length of drop pipe **168** ft. capacity **10** g.p.m.
Type:
 Submersible Turbine
 Jet Reciprocating
 Centrifugal Other

16 Remarks: elevation

Topography:
 Hill
 Slope
 Upland
 Valley

17 Water well contractor's certification:
This well was drilled under my jurisdiction and this report is true to the best of my knowledge and belief.
JOE'S WELL SERVICE **179**
Business name License No.
Address **Box 17h Cimarron, Ks.**
Signed **Ray Crick** Date **6-6-75**
Authorized Representative

Dave Hewes

Ingalls, Kansas 67853

Medium coarse sand	240 255
" " "	255 270
" " "	270 275
Clay & blue shale	275 285