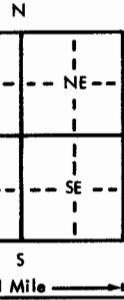


USE TYPEWRITER OR BALL
POINT PEN-PRESS Firmly,
PRINT CLEARLY.

WATER WELL RECORD
KSA 82g-1201-1215

**Kansas Department of Health and
Environment-Division of Environment
(Water well Contractors)
Topeka, Kansas 66620**

1. Location of well:	County Gray	Fraction X⁴	Center of X⁴ SW 1/4	Section number 28	Township number T 25 S	Range number R 29 E/N	
2. Distance and direction from nearest town or city: 2 3/4 E & 1 S of Charleston	Street address of well location if in city:		3. Owner of well: Kevin Irsik R.R. or street: Ingalls, KS City, state, zip code:				
4. Locate with "X" in section below: 	Sketch map:		6. Bore hole dia. 26 in. Completion date 3-23-77 Well depth 171 ft. 7. <input type="checkbox"/> Cable tool <input type="checkbox"/> Rotary <input type="checkbox"/> Driven <input type="checkbox"/> Dug <input type="checkbox"/> Hollow rod <input type="checkbox"/> Jetted <input type="checkbox"/> Bored <input checked="" type="checkbox"/> Reverse rotary 8. Use: <input type="checkbox"/> Domestic <input type="checkbox"/> Public supply <input type="checkbox"/> Industry <input checked="" type="checkbox"/> Irrigation <input type="checkbox"/> Air conditioning <input type="checkbox"/> Stock <input type="checkbox"/> Lawn <input type="checkbox"/> Oil field water <input type="checkbox"/> Other 9. Casing: Material Steel Height Above or below Threaded <input type="checkbox"/> Welded <input checked="" type="checkbox"/> Surface 12 in. RMP <input type="checkbox"/> PVC <input type="checkbox"/> Weight 31 lbs./ft. Dia. 16 in. to 171 ft. depth Wall Thickness: inches or Dia. 16 in. to 171 ft. depth gage No. 188				
5. Type and color of material See attachment	From	To	10. Screen: Manufacturer's name Brown Type Louvered Dia. 16" Slot/gauze 125 Length 45 Set between 169 ft. and 124 ft. ft. and 124 ft. Gravel pack? Yes Size range of material. 1/4 x 1/4				
		11. Static water level: mo./day/yr. ft. below land surface Date					
		12. Pumping level below land surfaces: 72 ft. after hrs. pumping 1444 g.p.m. ft. after hrs. pumping g.p.m. Estimated maximum yield g.p.m.					
		13. Water sample submitted: mo./day/yr. Yes <input checked="" type="checkbox"/> No <input type="checkbox"/> Date					
		14. Well head completion: Pitless adapter 12 inches above grade					
		15. Well grouted? Yes With: <input type="checkbox"/> Neat cement <input checked="" type="checkbox"/> Bentonite <input type="checkbox"/> Concrete Depth: From 0 ft. to 10 ft.					
		16. Nearest source of possible contamination: None ft. <input type="checkbox"/> Direction <input type="checkbox"/> Type Observe Well disinfected upon completion? Yes <input checked="" type="checkbox"/> No <input type="checkbox"/>					
		17. Pump: Manufacturer's name Model number HP Volts 110 Length of drop pipe ft. capacity g.p.m. Type: <input type="checkbox"/> Submersible <input type="checkbox"/> Turbine <input type="checkbox"/> Jet <input type="checkbox"/> Reciprocating <input type="checkbox"/> Centrifugal <input type="checkbox"/> Other					
18. Elevation: Flat Topography: <input type="checkbox"/> Hill <input type="checkbox"/> Slope <input type="checkbox"/> Upland <input type="checkbox"/> Valley		19. Remarks: (Use a second sheet if needed)					
		20. Water well contractor's certification: This well was drilled under my jurisdiction and this report is true to the best of my knowledge and belief. Henkle Drilg. & Supply 145 Business name Box 639 Garden City, KS License No. Address Box 639 Garden City, KS Signed E. L. Henkle Date 4-7-77 Authorized representative					

Forward the white, blue and pink copies to the Department of Health and Environment

Form WWC-5

DRILLERS TEST LOG

CUSTOMERS NAME Kevin Irsik DATE 12-14-76
 STREET ADDRESS TEST # 1 E. Log
 CITY & STATE Ingalls, KS DRILLER Lee
 COUNTY Gray QUARTER SW SECTION 28 TOWNSHIP 25 RANGE 29

LOCATION 20' W. of pivot

WELL LOCATION

GARDEN CITY, KANSAS
PHONE 276-3273

HENKLE DRILLING & SUPPLY CO., INC.
IRRIGATION HEADQUARTERS

SUBLETTE, KANSAS
PHONE 675-4311

TEST HOLES*****STOCK WELLS*****IRRIGATION AND INDUSTRIAL WELLS*****