


LOCATION OF WATER WELL: County: **Gray** Fraction: **NW 1/4 NW 1/4 SE 1/4** Section Number: **29** Township Number: **T 25 S** Range Number: **R 29 E/W**

Distance and direction from nearest town or city street address of well if located within city? **from Ingalls, Ks. - 3 miles West of Ingalls, Ks. on the river road**

WATER WELL OWNER: **Slawson Drilling Co. Rig #6**
 RR#, St. Address, Box #: **P. O. Box 1409**
 City, State, ZIP Code: **Great Bend, Kansas 67530**
 Board of Agriculture, Division of Water Resources
 Application Number: **None**

LOCATE WELL'S LOCATION WITH AN "X" IN SECTION BOX:

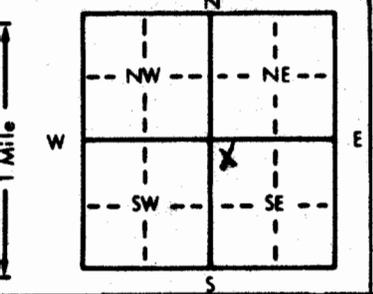

DEPTH OF COMPLETED WELL: **70** ft. ELEVATION:
 Depth(s) Groundwater Encountered 1. ft. 2. ft. 3. ft.
 WELL'S STATIC WATER LEVEL: **20** ft. below land surface measured on mo/day/yr **Dec. 5, 1981**
 Pump test data: Well water was ft. after hours pumping gpm
 Est. Yield: **75** gpm: Well water was ft. after hours pumping gpm
 Bore Hole Diameter: **8** in. to **70** ft., and in. to ft.
 WELL WATER TO BE USED AS:
 1 Domestic 3 Feedlot **6 Oil field water supply** 9 Dewatering 12 Other (Specify below)
 2 Irrigation 4 Industrial 7 Lawn and garden only 10 Observation well
 Was a chemical/bacteriological sample submitted to Department? Yes.....No.....~~XX~~; If yes, mo/day/yr sample was submitted
 Water Well Disinfected? Yes ~~XX~~ No

TYPE OF BLANK CASING USED:
 1 Steel 3 RMP (SR) 5 Wrought iron 8 Concrete tile CASING JOINTS: Glued ~~XX~~ Clamped
 2 **PVC** 4 ABS 6 Asbestos-Cement 9 Other (specify below) Welded
 7 Fiberglass Threaded
 Blank casing diameter: **5** in. to **70** ft., Dia. in. to ft., Dia. in. to ft.
 Casing height above land surface: **12** in., weight **200 psi** lbs./ft. Wall thickness or gauge No. **ADR 21**

TYPE OF SCREEN OR PERFORATION MATERIAL:
 1 Steel 3 Stainless steel 5 Fiberglass **7 PVC** 10 Asbestos-cement
 2 Brass 4 Galvanized steel 6 Concrete tile 8 RMP (SR) 11 Other (specify)
 12 None used (open hole)

SCREEN OR PERFORATION OPENINGS ARE:
 1 Continuous slot 3 Mill slot 5 Gauzed wrapped **8 Saw cut** 11 None (open hole)
 2 Louvered shutter 4 Key punched 6 Wire wrapped 9 Drilled holes
 7 Torch cut 10 Other (specify)

SCREEN-PERFORATED INTERVALS: From **25** ft. to **65** ft., From ft. to ft.
 From ft. to ft., From ft. to ft.
 GRAVEL PACK INTERVALS: From **10** ft. to **70** ft., From ft. to ft.
 From ft. to ft., From ft. to ft.

GROUT MATERIAL: 1 Neat cement 2 Cement grout **3 Bentonite** 4 Other
 Grout intervals: From **0** ft. to **10** ft., From ft. to ft., From ft. to ft.

What is the nearest source of possible contamination: **None**
 1 Septic tank 4 Lateral lines 7 Pit privy 10 Livestock pens 14 Abandoned water well
 2 Sewer lines 5 Cess pool 8 Sewage lagoon 11 Fuel storage 15 Oil well/Gas well
 3 Watertight sewer lines 6 Seepage pit 9 Feedyard 12 Fertilizer storage 16 Other (specify below)
 13 Insecticide storage

Direction from well? How many feet?

| FROM | TO | LITHOLOGIC LOG | FROM | TO | LITHOLOGIC LOG |
|------|----|-------------------------------------|------|----|----------------|
| 0 | 15 | Sandy topsoil | | | |
| 15 | 30 | Coarse sand | | | |
| 30 | 45 | " " | | | |
| 45 | 60 | Coarse sand & brown clay | | | |
| 60 | 75 | " " " " | | | |

CONTRACTOR'S OR LANDOWNER'S CERTIFICATION: This water well was (1) constructed, (2) reconstructed, or (3) plugged under my jurisdiction and was completed on (mo/day/year) **Dec. 5, 1981** and this record is true to the best of my knowledge and belief. Kansas Water Well Contractor's License No. **179** This Water Well Record was completed on (mo/day/yr) **June 22, 1982** under the business name of **Joe's Well Service, Inc. Cimarron, Ks.** by (signature) **Larry Crick**

INSTRUCTIONS: Use typewriter or ball point pen, PLEASE PRESS FIRMLY and PRINT clearly. Please fill in blanks, underline or circle the correct answers. Send top three copies to Kansas Department of Health and Environment, Division of Environment, Environmental Geology Section, Topeka, KS 66620. Send one to WATER WELL OWNER and retain one for your records.

OFFICE USE ONLY T 25 R 29 SEC 29 NW 1/4 NW 1/4 SE 1/4