


1 LOCATION OF WATER WELL: Fraction C 1/4 SE 1/4 NE 1/4 Section Number 34 Township Number T 25 S Range Number R 29 NW
 County: Groves

Distance and direction from nearest town or city street address of well if located within city?
2 miles west of Ingalls, Ks

2 WATER WELL OWNER: Rad Tigar Drilling Co Board of Agriculture, Division of Water Resources
 RR#, St. Address, Box #: 6720 5th St Bldg City, State, ZIP Code: Wichita, Ks 67202 Application Number: 787-438
Robert Egbert

3 LOCATE WELL'S LOCATION WITH AN "X" IN SECTION BOX:
 4 DEPTH OF COMPLETED WELL: 52 ft. ELEVATION: 9-31-87 ft.

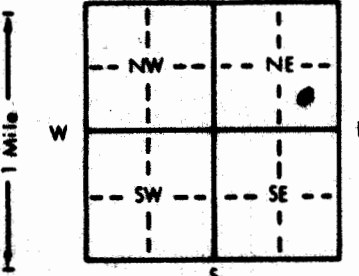

Depth(s) Groundwater Encountered: 1 ft. 2. ft. 3. ft.
 WELL'S STATIC WATER LEVEL: 22 ft. below land surface measured on mo/day/yr
 Pump test data: Well water was ft. after hours pumping gpm
 Est. Yield gpm: Well water was ft. after hours pumping gpm
 Bore Hole Diameter: 4 in. to in. and in. to in.
 WELL WATER TO BE USED AS:
 1 Domestic 3 Feedlot 6 Oil field water supply 9 Dewatering 12 Other (Specify below)
 2 Irrigation 4 Industrial 7 Lawn and garden only 10 Observation well
 Was a chemical/bacteriological sample submitted to Department? Yes No X If yes, mo/day/yr sample was submitted
 Water Well Disinfected? Yes No X

5 TYPE OF BLANK CASING USED:
 1 Steel 3 RMP (SR) 5 Wrought iron 8 Concrete tile CASING JOINTS: Glued X Clamped
 2 PVC 4 ABS 6 Asbestos-Cement 9 Other (specify below) Welded
 Blank casing 5 in. Dia. in. to ft., Dia. in. to ft.
 Casing height 3' below land surface in., weight lbs./ft. Wall thickness or gauge No.

TYPE OF SCREEN OR PERFORATION MATERIAL:
 1 Steel 3 Stainless steel 5 Fiberglass 8 RMP (SR) 10 Asbestos-cement
 2 Brass 4 Galvanized steel 6 Concrete tile 9 ABS 11 Other (specify)
 12 None used (open hole)

SCREEN OR PERFORATION OPENINGS ARE:
 1 Continuous slot 3 Mill slot 5 Gauzed wrapped 8 Saw cut 11 None (open hole)
 2 Louvered shutter 4 Key punched 6 Wire wrapped 9 Drilled holes
 7 Torch cut 10 Other (specify)

SCREEN-PERFORATED INTERVALS: From ft. to ft., From ft. to ft.
 From ft. to ft., From ft. to ft.
 GRAVEL PACK INTERVALS: From ft. to ft., From ft. to ft.
 From ft. to ft., From ft. to ft.

6 GROUT MATERIAL: 5 Neat cement 2 Cement grout 3 Bentonite 4 Other
 Grout intervals: From 52 ft. to 3 ft., From ft. to ft., From ft. to ft.

What is the nearest source of possible contamination:
 1 Septic tank 4 Lateral lines 7 Pit privy 10 Livestock pens 14 Abandoned water well
 2 Sewer lines 5 Cess pool 8 Sewage lagoon 11 Fuel storage 15 Oil well/Gas well
 3 Watertight sewer lines 6 Seepage pit 9 Feedyard 12 Fertilizer storage 16 Other (specify below)
None

Direction from well? How many feet?

FROM	TO	LITHOLOGIC LOG	FROM	TO	LITHOLOGIC LOG
<u>52</u>	<u>3</u>	<u>Cement</u>	<u>6.6</u>	<u>cut</u>	<u>ft</u>
		<u>filled well with cement</u>			
		<u>cut casing off 3' below ground level</u>			
		<u>filled with surface silts from 3' below to ground level</u>			

7 CONTRACTOR'S OR LANDOWNER'S CERTIFICATION: This water well was (1) constructed, (2) reconstructed, or (3) plugged under my jurisdiction and was completed on (mo/day/year) 10-21-87 and this record is true to the best of my knowledge and belief. Kansas Water Well Contractor's License No. This Water Well Record was completed on (mo/day/yr) 10-21-87 under the business name of Rad Tigar Drilling Co by (signature) Steve Dinkler

OFFICE USE ONLY T 25 R 29 E/W SEC 34 C 1/4 SE 1/4 NE 1/4