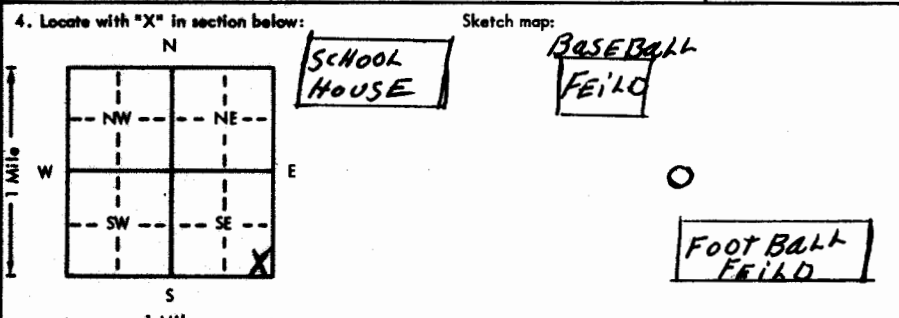


USE TYPEWRITER OR BALL POINT PEN-PRESS FIRMLY, PRINT CLEARLY.

WATER WELL RECORD  
KSA 82a-1201-1215

Kansas Department of Health and Environment-Division of Environment  
(Water well Contractors)  
Topeka, Kansas 66620

Sent to Leonard  
5/23/78

1. Location of well:	County <b>Gray</b>	Fraction <b>SE 1/4 SE 1/4 SE 1/4</b>	Section number <b>#36</b>	Township number <b>T #25</b>	Range number <b>S R #29</b>	<b>E 0</b>
2. Distance and direction from nearest town or city: <b>located in the City of Ingalls, Ks.</b> <small>Street address of well location if in city:</small>			3. Owner of well: <b>Ingalls Schools</b> <small>R.R. or street:</small> City, state, zip code: <b>Ingalls, Kansas 67853</b>			
4. Locate with "X" in section below: 			6. Bore hole dia. <b>10</b> in. Completion date <b>3-1-78</b> Well depth <b>225</b> ft.			
5. Type and color of material			7. Cable tool <input checked="" type="checkbox"/> Rotary <input type="checkbox"/> Driven <input type="checkbox"/> Dug <input type="checkbox"/> Hollow rod <input type="checkbox"/> Jetted <input type="checkbox"/> Bored <input type="checkbox"/> Reverse rotary			
			8. Use: <input type="checkbox"/> Domestic <input checked="" type="checkbox"/> Public supply <input type="checkbox"/> Industry <input checked="" type="checkbox"/> Irrigation <input type="checkbox"/> Air conditioning <input type="checkbox"/> Stock <input type="checkbox"/> Lawn <input type="checkbox"/> Oil field water <input type="checkbox"/> Other			
From			9. Casing: Material <b>Steel</b> Weight: Above or below Threaded <input type="checkbox"/> Welded <input checked="" type="checkbox"/> Surface <input type="checkbox"/> in. RMP <input type="checkbox"/> PVC <input type="checkbox"/> Weight <input type="checkbox"/> lbs./ft. Dia. <b>10</b> in. to <b>225</b> ft. depth Wall Thickness: inches or Dia. <input type="checkbox"/> in. to <input type="checkbox"/> ft. depth gage No. <b>100</b>			
			10. Screen: Manufacturer's name <b>Taylor</b> Type <b>10" steel</b> Dia. <b>10</b> Slot <b>1/16"</b> Length <b>40</b> ft. Set between <b>130</b> ft. and <b>150</b> ft. <b>20</b> ft. and <b>225</b> ft. Gravel pack? <input checked="" type="checkbox"/> <b>YES</b> Size range of material <b>2"</b>			
Top soil & fine sand			11. Static water level: <b>47</b> ft. below land surface Date <b>3-2-78</b> no./day/yr.			
Fine sand & sand rock			12. Pumping level below land surfaces: <b>50</b> ft. after <b>1</b> hrs. pumping <b>80</b> g.p.m. <input type="checkbox"/> ft. after <input type="checkbox"/> hrs. pumping <input type="checkbox"/> g.p.m. Estimated maximum yield <b>200</b> g.p.m.			
Sand rock & medium to coarse sand			13. Water sample submitted: <input checked="" type="checkbox"/> Yes <input type="checkbox"/> No Date <input type="checkbox"/>			
Medium to coarse sand			14. Well head completion: <input checked="" type="checkbox"/> Pitless adapter <b>12</b> inches above grade			
Fine to medium sand			15. Well grouted? <input checked="" type="checkbox"/> <b>YES</b> With: <input type="checkbox"/> Neat cement <input checked="" type="checkbox"/> Bentonite <input type="checkbox"/> Concrete Depth: From <b>0</b> ft. to <b>10</b> ft.			
Medium sand			16. Nearest source of possible contamination: <b>None to</b> ft. Direction <b>over land</b> Well disinfected upon completion? <input checked="" type="checkbox"/> Yes <input type="checkbox"/> No			
Fine to medium sand in layers			17. Pump: <input checked="" type="checkbox"/> Not installed Manufacturer's name <input type="checkbox"/> Model number <input type="checkbox"/> HP <input type="checkbox"/> Volts <input type="checkbox"/> Length of drop pipe <input type="checkbox"/> ft. capacity <input type="checkbox"/> g.p.m. Type: <input type="checkbox"/> Submersible <input type="checkbox"/> Turbine <input type="checkbox"/> Jet <input type="checkbox"/> Reciprocating <input type="checkbox"/> Centrifugal <input type="checkbox"/> Other			
Medium to coarse sand			18. Elevation:			
Clay & fine sand			19. Remarks:			
Fine to medium sand & clay layers			20. Water well contractor's certification: This well was drilled under my jurisdiction and this report is true to the best of my knowledge and belief. <b>JOE'S WELL SERVICE</b> <b>179</b> Business name License No. Address <b>Box 17h Cimarron, Ks.</b> Signed <b>James C. Cook</b> Date <b>5-26-</b> Authorized representative			
Clay			Topography: <input checked="" type="checkbox"/> Hill <input type="checkbox"/> Slope <input type="checkbox"/> Upland <input type="checkbox"/> Valley			
Clay & fine to medium sand			21. 25 290 36 SE SE SE			
Medium sand			22. 1/4 1/4 1/4			
Medium to coarse sand			23. 240			
Rock (Use a second sheet if needed)			24. Form WWC-5			

Forward the white, blue and pink copies to the Department of Health and Environment

Form WWC-5