


1 LOCATION OF WATER WELL: County: **GRAY** Fraction:  $\frac{1}{4}$   $\frac{1}{4}$  NW  $\frac{1}{4}$  Section Number: Township Number: **T 25 S** Range Number: **R 29**

Distance and direction from nearest town or city street address of well if located within city? **36**

**1/2 m. west hwy 50 ingalls 1/8 m. n.**

2 WATER WELL OWNER: **INGALLS TOWNSHIP**  
 RR#, St. Address, Box #: **INGALLS, KS. 67853**  
 City, State, ZIP Code: **Board of Agriculture, Division of Water Resources**  
 Application Number:

3 LOCATE WELL'S LOCATION WITH AN "X" IN SECTION BOX:

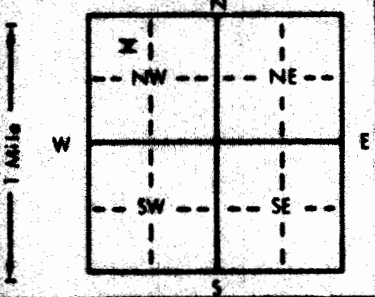

4 DEPTH OF COMPLETED WELL: **245** ft. ELEVATION:  
 Depth(s) Groundwater Encountered 1. .... ft. 2. .... ft. 3. .... ft.  
 WELL'S STATIC WATER LEVEL: **120** ft. below land surface measured on mo/day/yr **4/10/81**  
 Pump test data: Well water was .... ft. after .... hours pumping  
 Est. Yield .... gpm: Well water was .... ft. after .... hours pumping  
 Bore Hole Diameter: **9.7/8** in. to **253** ft., and .... in. to  
 WELL WATER TO BE USED AS:  
 Domestic  Public water supply  Air conditioning  Injection well  
 3 Feedlot  6 Oil field water supply  9 Dewatering  12 Other (Specify below)  
 2 Irrigation  4 Industrial  Lawn and garden only  10 Observation well  
 Was a chemical/bacteriological sample submitted to Department? Yes.....No. .....; If yes, mo/day/yr sample was submitted  
 Water Well Disinfected? Yes  No

5 TYPE OF BLANK CASING USED:  
 1 Steel  3 RMP (SR)  6 Asbestos-Cement  9 Other (specify below)  
 PVC  4 ABS  7 Fiberglass  
 CASING JOINTS: Glued  Clamped  
 Welded  
 Threaded

Blank casing diameter: **5** in. to **225** ft., Dia. .... in. to .... ft., Dia. .... in. to .... ft.  
 Casing height above land surface: **18** in., weight **200** lbs./ft. Wall thickness or gauge No.

TYPE OF SCREEN OR PERFORATION MATERIAL:  
 1 Steel  3 Stainless steel  5 Fiberglass  PVC  10 Asbestos-cement  
 2 Brass  4 Galvanized steel  6 Concrete tile  8 RMP (SR)  11 Other (specify)  
 12 None used (open hole)

SCREEN OR PERFORATION OPENINGS ARE:  
 1 Continuous slot  Mill slot  6 Wire wrapped  8 Saw cut  11 None (open hole)  
 2 Louvered shutter  4 Key punched  7 Torch cut  10 Other (specify)

SCREEN-PERFORATED INTERVALS: From **225** ft. to **245** ft., From .... ft. to .... ft.  
 GRAVEL PACK INTERVALS: From .... ft. to .... ft., From .... ft. to .... ft.

6 GROUT MATERIAL:  1 Neat cement  Cement grout  3 Bentonite  4 Other  
 Grout intervals: From **0** ft. to **25** ft., From .... ft. to .... ft., From .... ft. to .... ft.

What is the nearest source of possible contamination:  
 1 Septic tank  4 Lateral lines  7 Pit privy  10 Livestock pens  14 Abandoned water well  
 2 Sewer lines  5 Cess pool  8 Sewage lagoon  11 Fuel storage  15 Oil well/Gas well  
 3 Watertight sewer lines  6 Seepage pit  9 Feedyard  12 Fertilizer storage  16 Other (specify below)  
 13 Insecticide storage  CEMETARY  
 Direction from well? How many feet?

FROM	TO	LITHOLOGIC LOG	FROM	TO	LITHOLOGIC LOG
0	7	TOP SOIL			
7	52	BROWN SANDY CLAY			
52	70	FINE TO MED SAND AND GRAVEL			
70	81	BROWN SANDY CLAY			
81	100	FINE TO MED SAND AND GRAVEL			
100	112	BROWN SANDY CLAY			
112	205	FINE TO MED SAND			
205	210	BROWN SANDY CLAY			
210	217	FINE TO MED SAND			
217	234	BROWN CLAY			
234	245	FINE TO MED SAND AND GRAVEL			

7 CONTRACTOR'S OR LANDOWNER'S CERTIFICATION: This water well was  constructed, (2) reconstructed, or (3) plugged under my jurisdiction and was completed on (mo/day/year) **4/10/81** and this record is true to the best of my knowledge and belief. Kansas Water Well Contractor's License No. **172** This Water Well Record was completed on (mo/day/yr) **5/82**  
 under the business name of **JONAGAN DRILLING CO.** by (signature)

INSTRUCTIONS: Use typewriter or ball point pen, PLEASE PRESS FIRMLY and PRINT clearly. Please fill in blanks, underline or circle the correct answers. Send two copies to Kansas Department of Health and Environment, Division of Environment, Environmental Geology Section, Topeka, KS 66620. Send one to WATER WELL OWNER and retain one for your records.